4649 704 112 (9:30)

...LL COUNTY HEALTH DEPARTMENT Authorization to Construct

STATESVILLE 704-878-5305 MOORESVILLE 704-664-5281

...ROVEMENT PERMIT / ~~CERTIFICATE OF COMPLETION~~ / OPERATION PERMIT / EXISTING SYSTEM INSPECTION

PROPERTY DESCRIPTION NO. 22988 DATE 1/27/96 TAX MAP NO. Pt of 2E-A-6 Watershed: ☐ Yes ☑ No

OWNER OR CONTRACTOR Ronald C. Neill PHONE: Business 278-5000 Home 663-1697

ADDRESS 441 Barfield Road

LOCATION 21N, Lt on Barfield, At end of 01-De-56

SUBDIVISION _____ BLOCK / SECTION _____ LOT _____ LOT AREA ± 2 acres SITE CLASS PS DESIGN FLOW 360 L.T.A.R. 0.3 gpd/ft²

Septic Tank: 1000 Gallons; STB 794 Date 8-8-96

Pump Tank: _____ Gallons; PT _____ Date _____

Pump Make: _____ Model _____ Serial No. _____

Nitrification Field: No Fields 1 Square Feet 120 Linear Feet 400

No Lines 4 Trench Width 3' Max Trench Bottom Depth 30" Gravel Depth _____

☑ New System ☐ Repair System Type: I, II, III, IV, V, VI

System Description: Conv. Gravity

Repair System Description: Conv. Gravity

Maintenance Agreement Required: ☐ Yes ☑ No

☑ House/Mod. Home No. Bedrooms 3

☐ Mobile Home No. Bathrooms 2

☐ Business No. Employees _____

☐ Other _____


☐ Slab ☑ Crawl Space ☐ Basement w/plumbing ☐ Basement wo/plumbing

Water Supply: ☑ Individual ☐ Community ☐ Public To Be Drilled

Comments: Several Old Buildings on Site to Be Torn Down Keep Well 100' minimum from septic system

Comments:

INITIAL SITE SKETCH

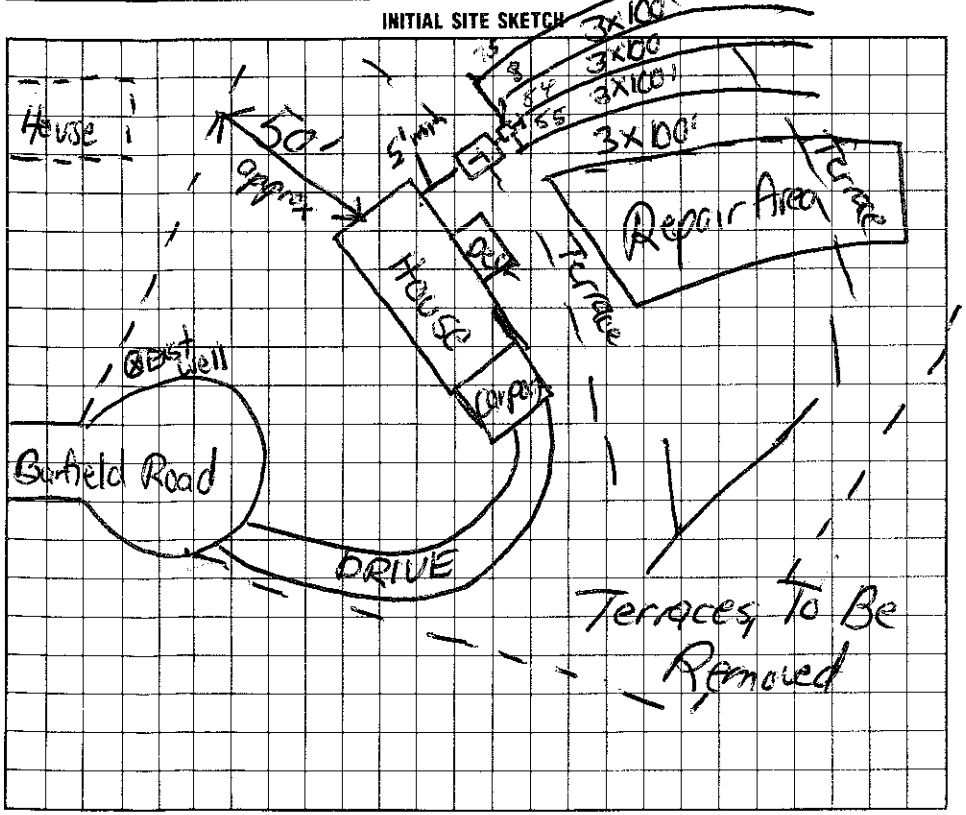

AS BUILT SKETCH

I understand that this permit can be suspended or revoked if any false information is supplied toward securing the permit/any unauthorized changes are made to the site/any unauthorized changes are made in the installation of the system.

Authorization To Construct Is Valid For Five Years from Date of Issuance.

Signed Ronald C. Neill Installed by: LARRY BEAM

Improvement Permit by: _____ date 1/27/96

Authorization To Construct by: _____ date 1/27/96

Existing System Inspection by: _____

Certificate of Completion by: _____ date _____

Operation Permit by: _____ date 10/15/96

HEALTH DEPT. COPY: WHITE INSPECTION COPY (FINAL): GREEN OWNER COPY (FINAL): YELLOW INSPECTION COPY (INITIAL): PINK OWNER COPY (INITIAL): GOLD