IREDELL COUNTY HEALTH DEPARTMENT

STATESVILLE 704-878-5305 MOORESVILLE 704-

IMPROVEMENT PERMIT / ~~CERTIFICATE OF COMPLETION~~ / OPERATION PERMIT / EXISTING SYSTEM INSPECTION

Watershed: ☑ Yes ☐ No

PROPERTY DESCRIPTION NO. 26368 DATE 4/28/97 TAX MAP NO. 4649 74 51 76 pt 1 PHONE: Business Home 528-0673

OWNER OR CONTRACTOR DEAN SANDERS

ADDRESS 464 PARKER TOWN RD. TROUTMAN TL PARKER TOWN · FIRST DRIVE LT.

LOCATION 21 N. TL FLOWER HOUSE - TL RANKEN WELL - ~~CENTER OF PARKER TOWN~~

SUBDIVISION — BLOCK / SECTION — LOT 8 LOT AREA ≈9.0 SITE CLASS. PS DESIGN FLOW 480 L.T.A.R. 3 GPD/FT

Septic Tank: 1000 Gallons; STB 1012 Date 5/6/97

Pump Tank: Gallons; PT Date

Pump Make: Model Serial No.

Nitrification Field: No Fields 1 Square Feet 1600 Linear Feet 533

No Lines 4 @ 133' Trench Width 36" Max Trench Bottom Depth 36" Gravel Depth 12"

☑ New System ☐ Repair System Type: I, II, III, IV, V, VI

System Description: GRAVITY CONVENTIONAL

Repair System Description: SAME

Maintenance Agreement Required: ☐ Yes ☑ No

☐ House/Mod. Home ☑ Mobile Home ☐ Business ☐ Other

No. Bedrooms 4/3 No. Bathrooms No. Employees


☐ Slab ☑ Crawl Space ☐ Basement w/plumbing ☐ Basement wo/plumbing

Water Supply: ☑ Individual ☐ Community ☐ Public

Comments:

Comments: Installed as shown.

INITIAL SITE SKETCH * NOT TO SCALE *

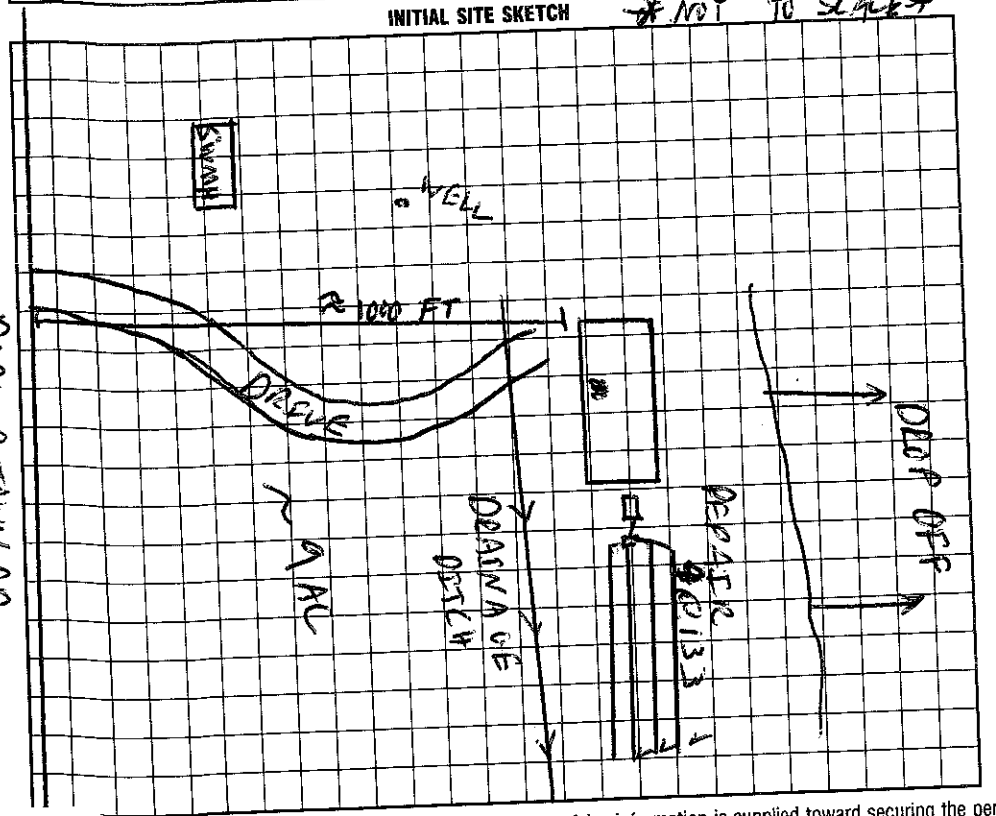

AS BUILT SKETCH

I understand that this permit can be suspended or revoked if any false information is supplied toward securing the permit/any unauthorized changes are made to the site/any unauthorized changes are made in the installation of the system. This permit is valid for 60 months from date of issuance.

Installed by: Don Lackey

Certificate of Completion by: W. [illegible]

Operation Permit by: W. [illegible]

date 4/28/97

date 4/28/97

OWNER COPY (FINAL): YELLOW