IREDELL COUNTY HEALTH DEPARTMENT

STATESVILLE 704-878-5305 MOORESVILLE 704-664-5281

IMPROVEMENT PERMIT / AUTHORIZATION TO CONSTRUCT / OPERATION PERMIT / EXISTING SYSTEM INSPECTION

PERMIT# 133149 PIN# ~~4649445559~~ 4649748371 DATE 1-30-06

OWNER OR APPLICANT Freedom Homes - Robert Ingebritsen PHONE: Business 704-433-1828 Home 704-528-7960

ADDRESS 1042 Charlotte Hwy Troutman

LOCATION Hwy 21 N TL Flower House Rd TR Rankin Hill Rd on left (383 Rankin Hill Rd)

SUBDIVISION _____ BLOCK / SECTION _____ LOT _____ LOT AREA 9.623 Ac SITE CLASS. PS DESIGN FLOW 480gpd L.T.A.R. .3

Septic Tank: 1000 Gallons; STB 1012 Date 6-15-05
Pump Tank: _____ Gallons; PT _____ Date _____
Pump Make: _____ Model _____ Serial No. _____
Nitrification Field: No Fields 1 Square Feet 1600 Linear Feet 400
No Lines 4@100' Trench Width 36" Max Trench Bottom Depth 36" Gravel Depth NA

☒ New System ☐ Repair ☐ Expansion System Type: I II III IV V VI
System Description: 25% red. gravity
Repair System Description: 25% red. pump
Maintenance Agreement Required: ☐ Yes ☒ No

☒ House/Mod. Home No. Bedrooms 4
☐ Mobile Home No. Persons ____
☐ Business No. Employees ____
☐ Other _____

Water Supply: ☒ Individual ☐ Public ☐ Community


☒ Gravity ☐ Pressure ☐ Slab ☒ Crawl Space ☐ Basement w/plumbing ☐ Basement wo/plumbing

Comments/Conditions: First trench starts 10' from side of house and 15' below back of house
Place well 100'+ from septic system

Comments/Conditions:
Yellow duffite filter
Septic tank w/ marker

1" = 100'

INITIAL SITE SKETCH

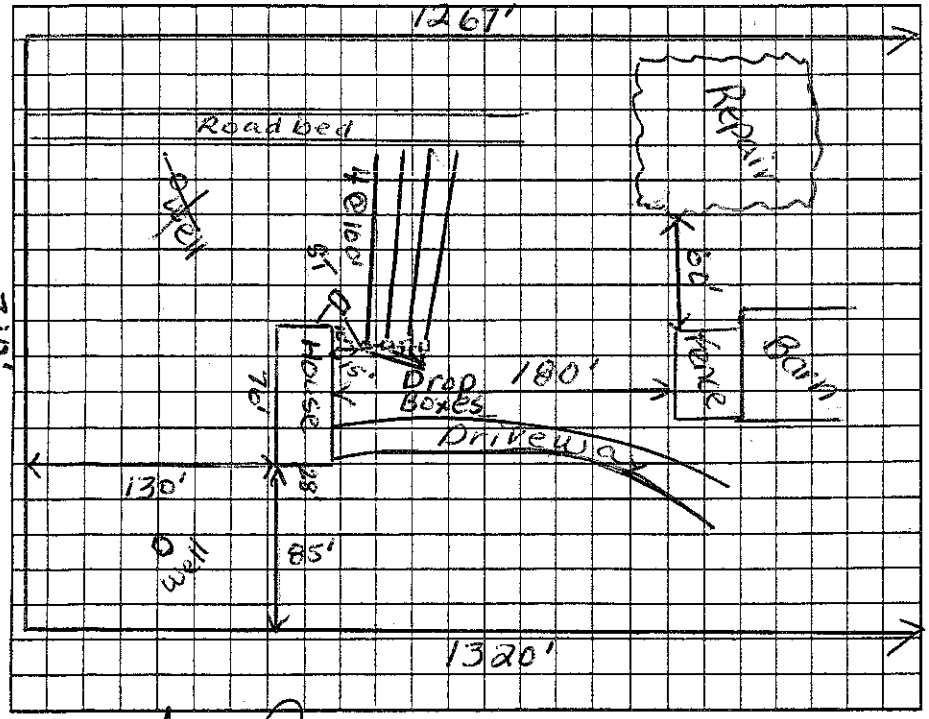


AS BUILT SKETCH

System installed as per initial site sketch except lines curve more than as originally drawn and septic tank is in back of house.

Installed Quicky chambers - 25 per trench

New well installed in location shown

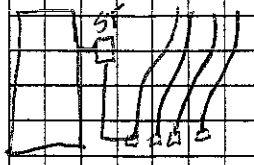

Permit can be suspended or revoked if any false information is supplied toward securing the permit/any unauthorized changes are made to the site/any unauthorized changes are made in the installation of the system. Improvement Permit with plat valid without expiration ☐ Improvement Permit with site plan valid for sixty months ☒ Authorization to Construct is valid for a period equal to that of Improvement Permit – not to exceed sixty months.

Signed: _____ date 1-30-06 Installed by: Piedmont Backhoe

Improvement Permit by: Judy Melville date 1-30-06 Operation Permit by: Judy Melville date 2-21-06

Authorization to Construct by: Judy Melville date 1-30-06 Existing System Inspection by: _____ date _____

HEALTH DEPT. COPY: WHITE OWNER COPY (FINAL): YELLOW OWNER COPY (INITIAL): PINK