IREDELL COUNTY HEALTH DEPARTMENT

STATESVILLE 704-878-5305 155.00 Paid MOORESVILLE 704-664-5281

400 Commercial Services of Stanfield

IMPROVEMENT PERMIT / AUTHORIZATION TO CONSTRUCT / OPERATION PERMIT / EXISTING SYSTEM INSPECTION

PERMIT# 103754 PIN# 4649-75-0566.6 4649 75 0095 DATE April 19 02

OWNER OR CONTRACTOR Primestar Properties PHONE: Business Home

ADDRESS 1709 South Main Kannapolis 28081

LOCATION 115-21N TL Flowers House Loop (Revised) TL Rankin Hill Rd. ± 1 Mile on Right (2nd new street past Westwinds)

SUBDIVISION Magic Forest BLOCK / SECTION 1 LOT 6 (Revised) LOT AREA 1.44AC SITE CLASS. P3 DESIGN FLOW 360gpd L.T.A.R. .25

Septic Tank: 1000 Gallons; STB 794 Date 3/29/02
Pump Tank: 1000 Gallons; PT 283 Date 3/22/02
Pump Make: Zoeller Model N98 Serial No. 98-0002
Nitrification Field: No Fields 1 Square Feet 1080 Linear Feet 360
No Lines 3@120' Trench Width 36" Max Trench Bottom Depth 36"

☑ New System ☐ Repair System Type: I, II, III, IV, V, VI
System Description: PM Innovative -25% Red.
Repair System Description: Same
Maintenance Agreement Required: ☐ Yes ☑ No


☐ House/Mod. Home No. Bedrooms 3
☑ Mobile Home No. Bathrooms 2
☐ Business No. Employees
☐ Other
Gravel Depth NA ☐ Slab ☑ Crawl Space ☐ Basement w/plumbing ☐ Basement wo/plumbing

Water Supply: ☑ Individual ☐ Public ☐ Community


Comments:/Conditions:
1"=50'

Comments:/Conditions:

INITIAL SITE SKETCH

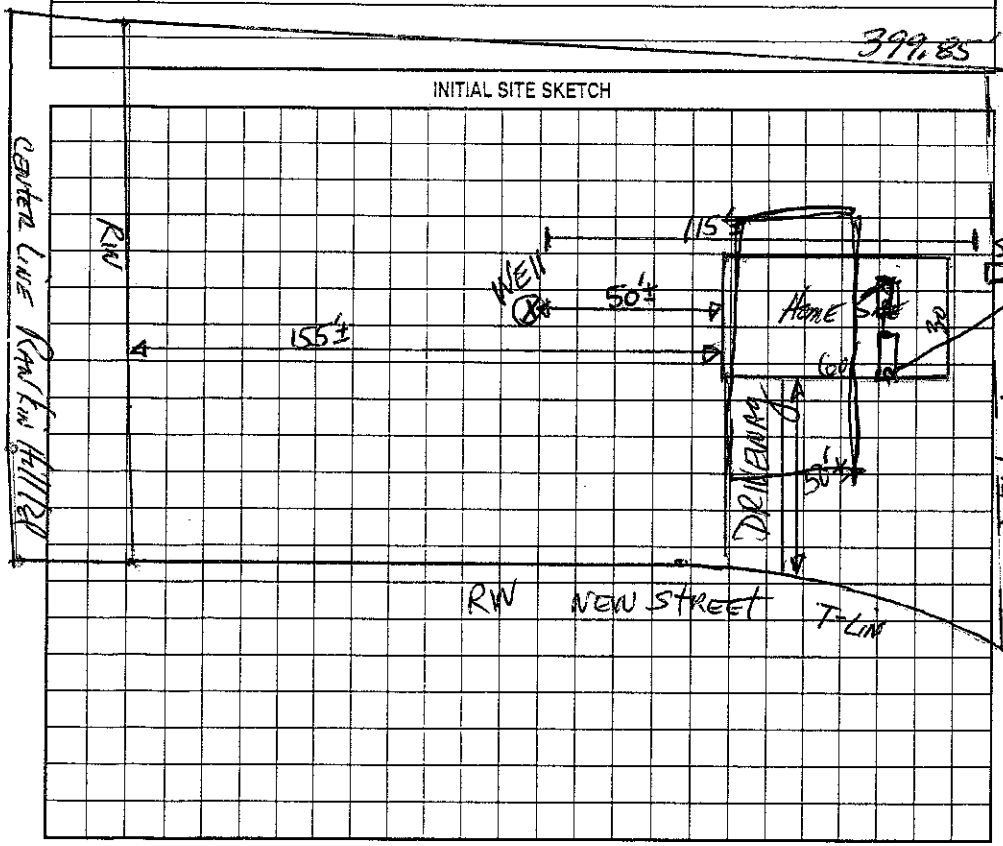

AS-BUILT SKETCH

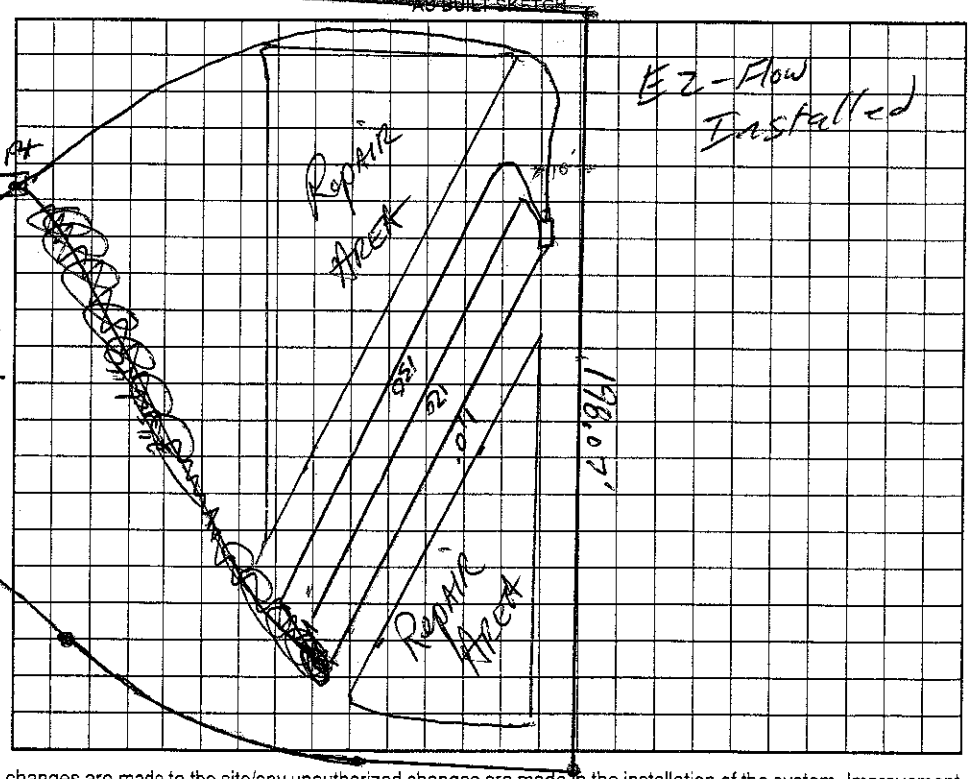

Permit can be suspended or revoked if any false information is supplied toward securing the permit/any unauthorized changes are made to the site/any unauthorized changes are made in the installation of the system. Improvement Permit with plat valid without expiration. Improvement Permit with site plan valid for sixty months. Authorization to Construct is valid for a period equal to that of Improvement Permit – not to exceed sixty months.

Signed: Joe Ferguson for Carlwood Date 4/24/02

Improvement Permit by: Mark Hinson RS Date 4-19-02

Authorization to Construct by: Wesley Sparks RS Date 4/24/02

Installed by: Commercial Services of Stanfield

Operation Permit by: Wesley Sparks RS Date 6/25/02

Existing System Inspection by: Date

HEALTH DEPT. COPY: WHITE OWNER COPY (FINAL): YELLOW OWNER COPY (INITIAL): PINK