IREDELL COUNTY HEALTH DEPARTMENT

STATESVILLE 704-878-5305 MOORESVILLE 704-664-5281

155.00 T&C

IMPROVEMENT PERMIT / AUTHORIZATION TO CONSTRUCT / OPERATION PERMIT / EXISTING SYSTEM INSPECTION

PERMIT# 104575 PIN# 4649 75 0566 4649 75 0279 DATE 3/12/02

OWNER OR CONTRACTOR Matthew Sanders PHONE: Business 704-948-8954 Home

ADDRESS 11819 Winter Pine Ln. Charlotte, NC. 28269

LOCATION Rankin Hill Rd., 115-21N TL Flower House hp. TL Rankin Hill Rd. on (R) before bridge

SUBDIVISION MAGIC FOREST BLOCK / SECTION 1 LOT 4 LOT AREA .78 AC SITE CLASS. PS DESIGN FLOW 360 L.T.A.R. .3

Septic Tank: 1000 Gallons; STB 794 Date 2/7/02

Pump Tank: 1000 Gallons; PT 283 Date 1/27/02

Pump Make: Bowen Model WED-311M Serial No. B02555 9

Nitrification Field: No Fields 1 Square Feet 900 Linear Feet 300

No Lines 4@75 Trench Width 3 Max Trench Bottom Depth 3 Gravel Depth NA

☑ New System ☐ Repair System Type: I, II, (III), IV, V, VI

System Description: PM → CN PLASTIC-EZ Flow

Repair System Description: SAME

Maintenance Agreement Required: ☐ Yes ☒ No

☒ House/Mod. Home No. Bedrooms 3

☐ Mobile Home No. Bathrooms 2

☐ Business No. Employees

☐ Other


☐ Slab ☒ Crawl Space ☐ Basement w/plumbing ☐ Basement wo/plumbing

Water Supply: ☒ Individual ☐ Public ☐ Community


Comments:/Conditions:

Comments:/Conditions: Tanks, Pump, Drainfield - 3/26/02

INITIAL SITE SKETCH (1" = 40')

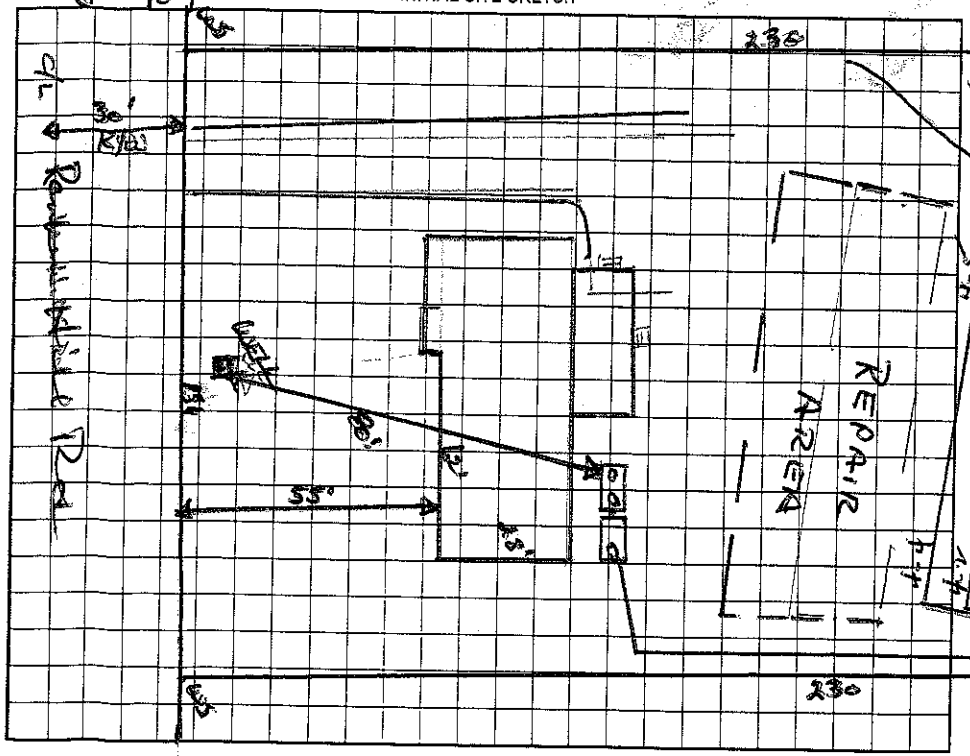

AS BUILT SKETCH

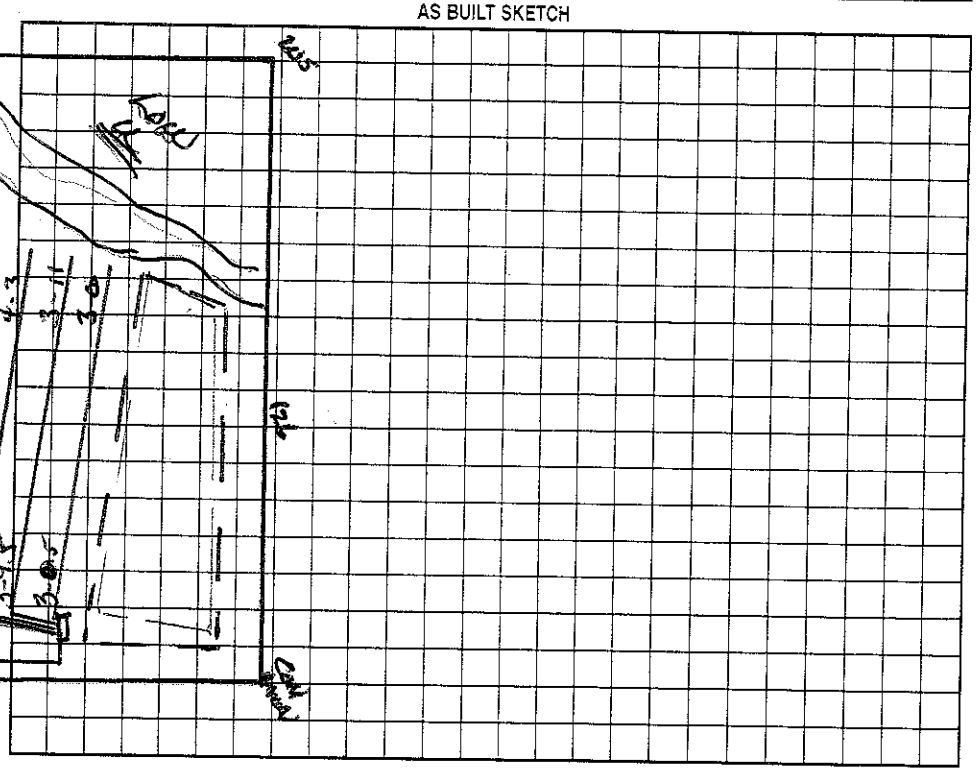

Permit can be suspended or revoked if any false information is supplied toward securing the permit/any unauthorized changes are made to the site/any unauthorized changes are made in the installation of the system. Improvement Permit with plat valid without expiration. Improvement Permit with site plan valid for sixty months. Authorization to Construct is valid for a period equal to that of Improvement Permit – not to exceed sixty months.

Signed: */Jennifer Sanders date

Improvement Permit by: Wesley Sparks RS. date 3/12/02

Authorization to Construct by: Wesley Sparks RS. date 3/12/02

Installed by: Perry Lamm

Operation Permit by: Wesley Sparks RS date 6/17/02

Existing System Inspection by: date

HEALTH DEPT. COPY: WHITE OWNER COPY (FINAL): YELLOW OWNER COPY (INITIAL): PINK