IREDELL COUNTY HEALTH DEPARTMENT

STATESVILLE 704-878-5305 130.00 Pd MOORESVILLE 704-664-5281

IMPROVEMENT PERMIT / AUTHORIZATION TO CONSTRUCT / OPERATION PERMIT / EXISTING SYSTEM INSPECTION

PERMIT# 105393 PIN# ~~4649-75-0463~~ 4649 75 0556 DATE 5/20/02

OWNER OR CONTRACTOR PRIMESTAR PROPERTIES / TERESA NEWTON PHONE: Business 932-9100 Home

ADDRESS 1709 SOUTH MAIN ST KANNAPOLIS NC 28081

LOCATION 21 N - TL FLOWERHOUSE LOOP - TL RANKEN HILL - FIRST LOT ON RT PAST LARIMIE CT

SUBDIVISION MAGIC FOREST BLOCK / SECTION 1 LOT 2 LOT AREA .78 AC SITE CLASS RS DESIGN FLOW 360 GPD L.T.A.R. - 3000/FT²

Septic Tank: 1000+ Gallons; STB 1052 Date 2/1/02

Pump Tank: 1000 Gallons; PT 17 Date 10/4/01

Pump Make: Myers Model MW50-1HP Serial No. 2688D901

Nitrification Field: No Fields 1 Square Feet 900 Linear Feet 300

No Lines 3@100' Trench Width 36" Max Trench Bottom Depth 36" Gravel Depth N/A

☑ New System ☐ Repair System Type: I, II, III, IV, V, VI

System Description: PUMP 25% REDUCTION

Repair System Description: LP PANEL

Maintenance Agreement Required: ☐ Yes ☑ No

☑ House/Mod. Home No. Bedrooms 3

☐ Mobile Home No. Bathrooms 3

☐ Business No. Employees

☐ Other


☐ Slab ☐ Crawl Space ☐ Basement w/plumbing ☐ Basement wo/plumbing

Water Supply: ☑ Individual ☐ Public ☐ Community

Comments:/Conditions: 1" = 50'

Comments:/Conditions:

INITIAL SITE SKETCH

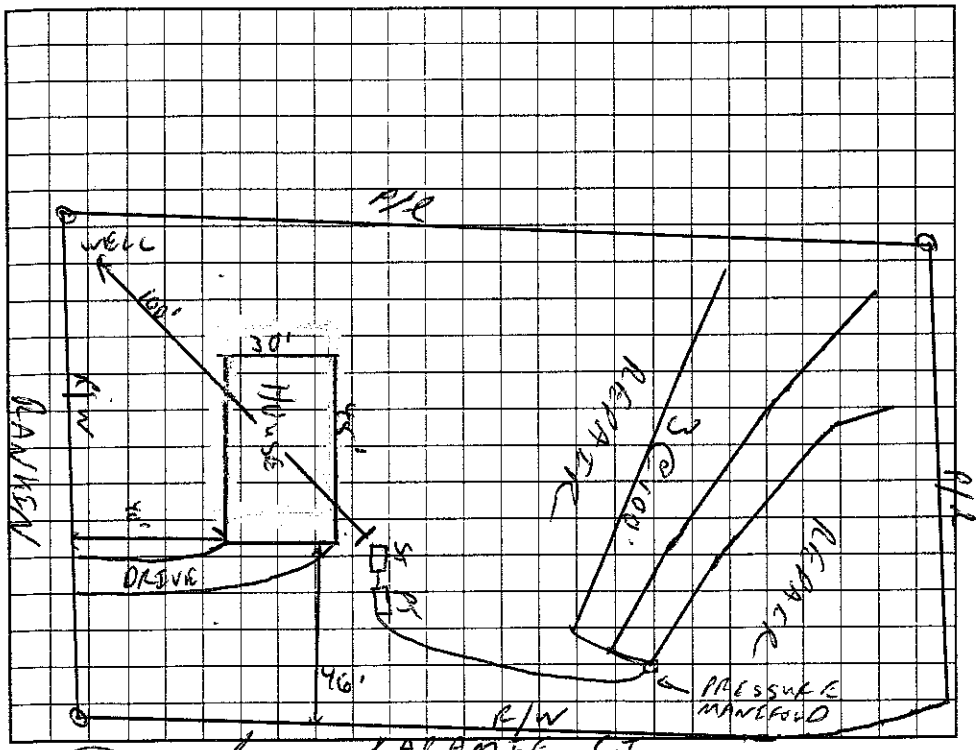

AS BUILT SKETCH

Permit can be suspended or revoked if any false information is supplied toward securing the permit/any unauthorized changes are made to the site/any unauthorized changes are made in the installation of the system. Improvement Permit with plat valid without expiration. Improvement Permit with site plan valid for sixty months. Authorization to Construct is valid for a period equal to that of Improvement Permit – not to exceed sixty months.

Signed: Teresa Newton date

Installed by: A-1 Backhoe

Improvement Permit by: C. Hyatt RS date 5/20/02

Operation Permit by: [signature] RS date 6/25/02

Authorization to Construct by: C. Hyatt RS date 5/20/02

Existing System Inspection by: date

HEALTH DEPT. COPY: WHITE OWNER COPY (FINAL): YELLOW OWNER COPY (INITIAL): PINK