IREDELL COUNTY HEALTH DEPARTMENT

STATESVILLE 704-878-5305 130.00 Paid MOORESVILLE 704-664-5281

IMPROVEMENT PERMIT / AUTHORIZATION TO CONSTRUCT / OPERATION PERMIT / EXISTING SYSTEM INSPECTION

PERMIT# 105413 PIN# 4649-75-0566, 28 4649-75-3253 DATE Aug 15, 02

OWNER OR CONTRACTOR Primestar Properties LLC / Tom Estes PHONE: Business (704) 932-9100 Home

ADDRESS 1709 S. Main Kannapolis, N.C. 28081

LOCATION 115-21N TL Flower House Loop TL Rankin Hill Rd. on left

SUBDIVISION Magic Forest BLOCK / SECTION LOT 28 LOT AREA .74Ac SITE CLASS. PS DESIGN FLOW 360gpd L.T.A.R. .3

Septic Tank: 1000 Gallons; STB 799 Date

Pump Tank: 1000 Gallons; PT 27 Date 8/17/03

Pump Make: Goulds Model WE0511M Serial No.

Nitrification Field: No Fields 1 Square Feet 1200 Linear Feet 400

No Lines 4 Trench Width 36" Max Trench Bottom Depth 36"

☑ New System ☐ Repair System Type: I, II, III, IV, V, VI

System Description: PM - CONVENTIONAL

Repair System Description: PM-LP 25% Reduction

Maintenance Agreement Required: ☐ Yes ☑ No

Gravel Depth 12" ☐ Slab ☑ Crawl Space ☐ Basement w/plumbing ☐ Basement wo/plumbing

☐ House/Mod. Home No. Bedrooms 3

☑ Mobile Home OW No. Bathrooms 2

☐ Business No. Employees

☐ Other

Water Supply: ☑ Individual ☐ Public ☐ Community


Comments:/Conditions:

Remove any old barns in septic system area.

Comments:/Conditions:

1"=50'

INITIAL SITE SKETCH

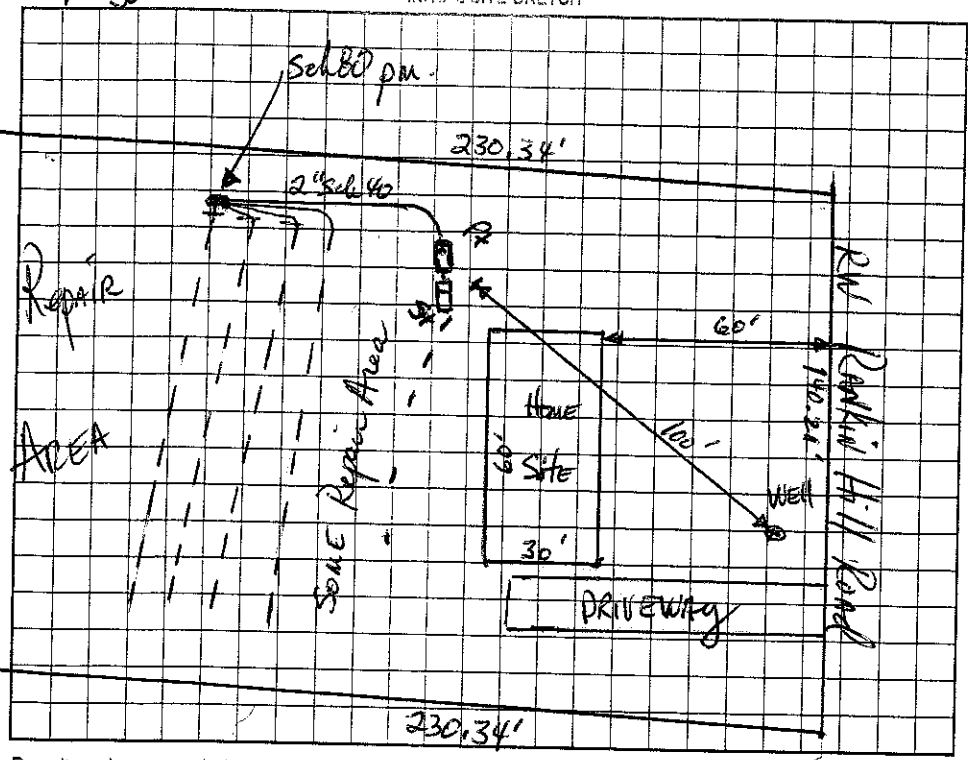

AS BUILT SKETCH

Permit can be suspended or revoked if any false information is supplied toward securing the permit/any unauthorized changes are made to the site/any unauthorized changes are made in the installation of the system. Improvement Permit with plat valid without expiration. Improvement Permit with site plan valid for sixty months. Authorization to Construct is valid for a period equal to that of Improvement Permit – not to exceed sixty months.

Signed: date 8-16-02 Installed by: Marty Tucker

Improvement Permit by: date 8-15-02 Operation Permit by: RS date 10/20/03

Authorization to Construct by: RS date 8/13/03 Existing System Inspection by: date

HEALTH DEPT. COPY: WHITE OWNER COPY (FINAL): YELLOW OWNER COPY (INITIAL): PINK