IREDELL COUNTY HEALTH DEPARTMENT

STATESVILLE 704-878-5305 MOORESVILLE 704-664-5281

10:00

IMPROVEMENT PERMIT / AUTHORIZATION TO CONSTRUCT / OPERATION PERMIT / EXISTING SYSTEM INSPECTION

PERMIT# 111672 PIN# 4649 75 0165. 37 4649755532 DATE 10/24/03

OWNER OR CONTRACTOR PRIMESTAR PROPERTIES / FULL SPECTRUM ~~HOMES~~ Business 938-9100 Home

ADDRESS 1709 S. MAIN ST. KANNAPOLIS NC 28081

LOCATION FLOWER HOUSE - TL RANKIN HILL - TL MAGIC FOREST CT - ON RT CORNER OF MYSTIC CT.

SUBDIVISION MAGIC FOREST BLOCK / SECTION IV LOT 34 LOT AREA .63AC SITE CLASS. PS DESIGN FLOW 360GPD L.T.A.R. .3610/FT²

Septic Tank: 1000 Gallons; STB 1012 Date 3-27-05

Pump Tank: ~~1000~~ Gallons; PT Date

Pump Make: Model Serial No.

Nitrification Field: No Fields 1 Square Feet 900 Linear Feet 300

No Lines 3@100' Trench Width 36" Max Trench Bottom Depth 36" Gravel Depth N/A

☒ ~~New System~~ ☐ Repair System Type: I, II, III, IV, V, VI

System Description: PUMP 25% REDUCTION

Repair System Description: PRESSURE UP PANEL

Maintenance Agreement Required: ☐ Yes ☒ ~~No~~

☒ ~~House/Mod. Home~~ No. Bedrooms 3

☐ Mobile Home No. Bathrooms 3

☐ Business No. Employees

☐ Other

☐ Slab ☑ Crawl Space ☐ Basement w/plumbing ☐ Basement wo/plumbing


Water Supply: ☒ ~~Individual~~ ☐ Public ☐ Community

Comments:/Conditions: 2/25/05 Changed to gravity 25% reduced lot clean & original lines would have to go into too much - DWS

1" = 50'

Comments:/Conditions: Used Quick 4 Plastic Chambers for Drainfield

INITIAL SITE SKETCH

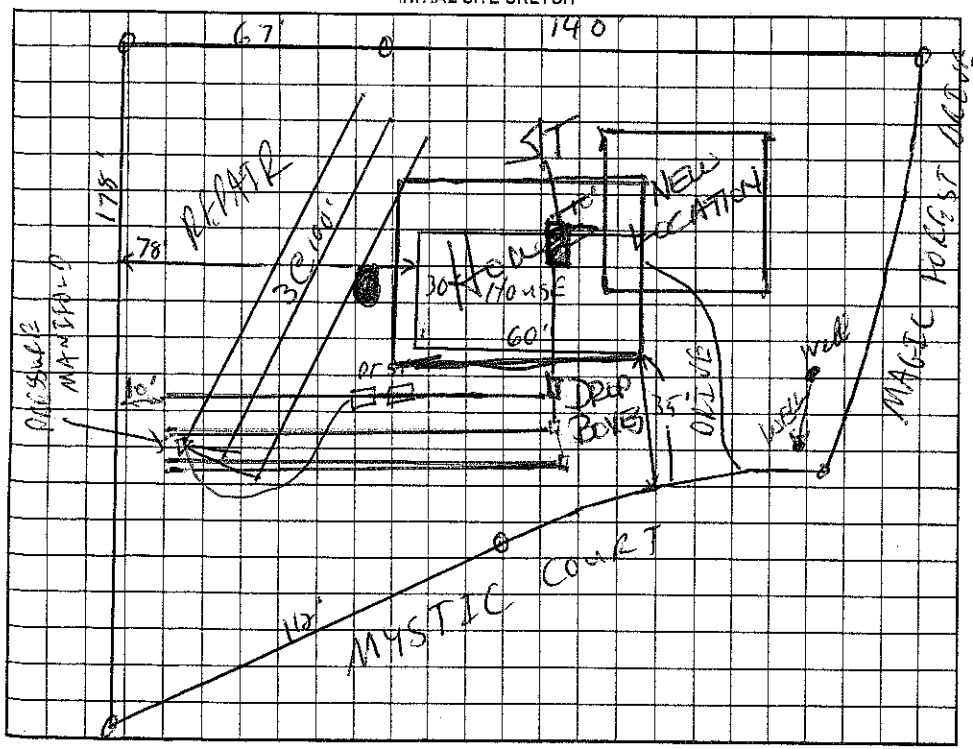

AS BUILT SKETCH

Permit can be suspended or revoked if any false information is supplied toward securing the permit/any unauthorized changes are made to the site/any unauthorized changes are made in the installation of the system. Improvement Permit with plat valid without expiration. Improvement Permit with site plan valid for sixty months. Authorization to Construct is valid for a period equal to that of Improvement Permit – not to exceed sixty months.

Signed: date 3-24-04

Improvement Permit by: KS date 10/27/03

Authorization to Construct by: Wesley Sparks RS date 8/8/05

Installed by: Craig Thompson RS

Operation Permit by: date 10/25/05

Existing System Inspection by: date

HEALTH DEPT. COPY: WHITE OWNER COPY (FINAL): YELLOW OWNER COPY (INITIAL): PINK