IREDELL COUNTY HEALTH DEPARTMENT

STATESVILLE 704-878-5305 MOORESVILLE 704-664-5281

IMPROVEMENT PERMIT / AUTHORIZATION TO CONSTRUCT / OPERATION PERMIT / EXISTING SYSTEM INSPECTION

PERMIT# 111869 PIN# ~~4649 75 0165 31~~ 4649-75-6014 DATE 4/28/04

OWNER OR CONTRACTOR Primestar Properties PHONE: Business 932-9100 Home

ADDRESS 1709 S. Main St. Kannapolis NC. 28081

LOCATION Rankin Hall, TL Magic Point - TR Mystic Ln on rt

SUBDIVISION Magic Point BLOCK / SECTION 4 LOT 31 LOT AREA 1.22 SITE CLASS. PS DESIGN FLOW 450 L.T.A.R. .3

Septic Tank: 1000 Gallons; STB Date

Pump Tank: 1000 Gallons; PT Date

Pump Make: Model Serial No.

Nitrification Field: No Fields 1 Square Feet 1200 Linear Feet 400

No Lines 4@100 Trench Width 3' Max Trench Bottom Depth 3' Gravel Depth

☒ New System ☐ Repair System Type: I, II, (III), IV, V, VI

System Description: Gravity - TYPE 3

Repair System Description: Pump And TYPE 3

Maintenance Agreement Required: ☐ Yes ☒ No

☒ House/Mod. Home No. Bedrooms 4

☐ Mobile Home No. Bathrooms 3

☐ Business No. Employees

☐ Other


☐ Slab ☒ Crawl Space ☐ Basement w/plumbing ☐ Basement wo/plumbing

Water Supply: ☒ Individual ☐ Public ☐ Community


Comments:/Conditions:

Comments:/Conditions:

INITIAL SITE SKETCH

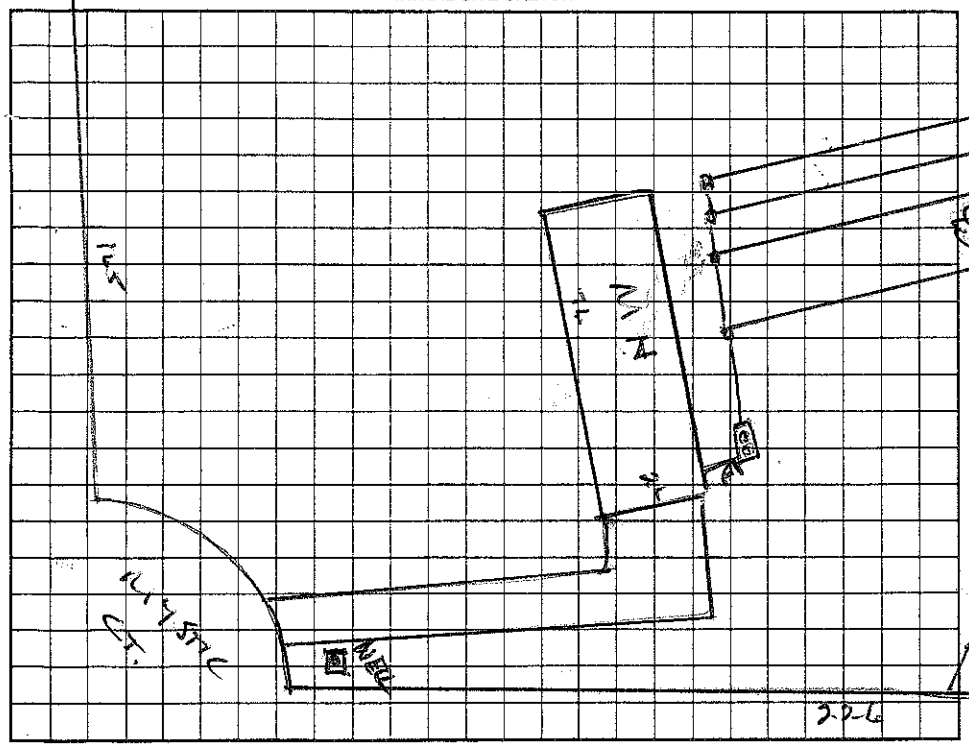

AS BUILT SKETCH

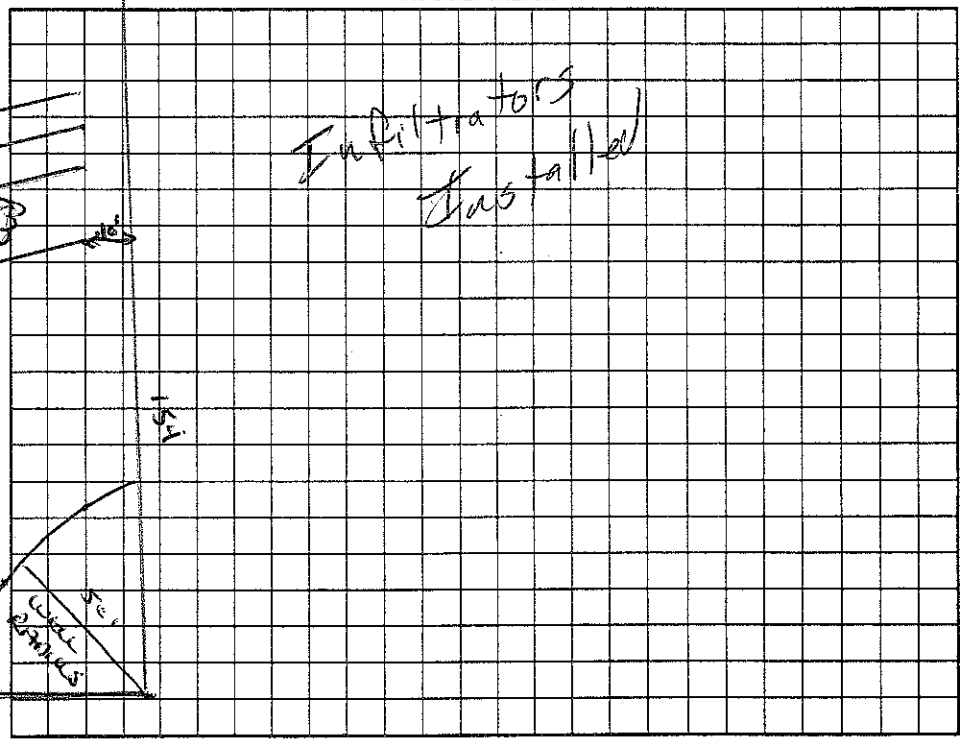

Permit can be suspended or revoked if any false information is supplied toward securing the permit/any unauthorized changes are made to the site/any unauthorized changes are made in the installation of the system. Improvement Permit with plat valid without expiration. Improvement Permit with site plan valid for sixty months. Authorization to Construct is valid for a period equal to that of Improvement Permit – not to exceed sixty months.

Signed: date

Improvement Permit by: Wesley Sparks RS date 4/28/04

Authorization to Construct by: Wesley Sparks RS date 4/28/04

Installed by: Craig Thompson

Operation Permit by: RS date 4/29/04

Existing System Inspection by: date

HEALTH DEPT. COPY: WHITE OWNER COPY (FINAL): YELLOW OWNER COPY (INITIAL): PINK