IREDELL COUNTY HEALTH DEPARTMENT

STATESVILLE 704-878-5305 MOORESVILLE 704-664-5281

IMPROVEMENT PERMIT / AUTHORIZATION TO CONSTRUCT / OPERATION PERMIT / EXISTING SYSTEM INSPECTION

3:30 3:30-4:00

PERMIT# 111870 PIN# 4644 150165 4649-15-6118 DATE 10/24/03

OWNER OR CONTRACTOR PRIMESTAR PROPERTIES / Fleetwood PHONE: Business 932-9100 Home

ADDRESS 1709 SOUTH MAIN ST. KANNAPOLIS NC 28081

LOCATION RANKEN HILL - TL MAGIC FOREST - TR MYSTIC - ON RT AT END

SUBDIVISION MAGIC FOREST BLOCK / SECTION IV 4 LOT 32 LOT AREA .196AC SITE CLASS. FS DESIGN FLOW 360GPD L.T.A.R. .36/FP2

Septic Tank: 1000 Gallons; STB 1012 Date 11-1-02

Pump Tank: Gallons; PT Date

Pump Make: Model Serial No.

Nitrification Field: No Fields 1 Square Feet 900 Linear Feet 300

No Lines 4 @ 75' Trench Width 36" Max Trench Bottom Depth 36" Gravel Depth N/A

☑ New System ☐ Repair System Type: I, II, III, IV, V, VI

System Description: GRAVITY 250 REDUCTION

Repair System Description: SAME AS MANY PANEL

Maintenance Agreement Required: ☐ Yes ☐ No

☑ House/Mod. Home ☐ Mobile Home ☐ Business ☐ Other

No. Bedrooms 3 No. Bathrooms 3 No. Employees

☐ Slab ☑ Crawl Space ☐ Basement w/plumbing ☐ Basement wo/plumbing

Water Supply: ☑ Individual ☐ Public ☐ Community


Comments:/Conditions:

1"=50'


Comments:/Conditions:

* Old Well was discovered when lot was cleared - 24" 25' deep, was Abandoned Checked Tanks & lines 5/11/04

INITIAL SITE SKETCH

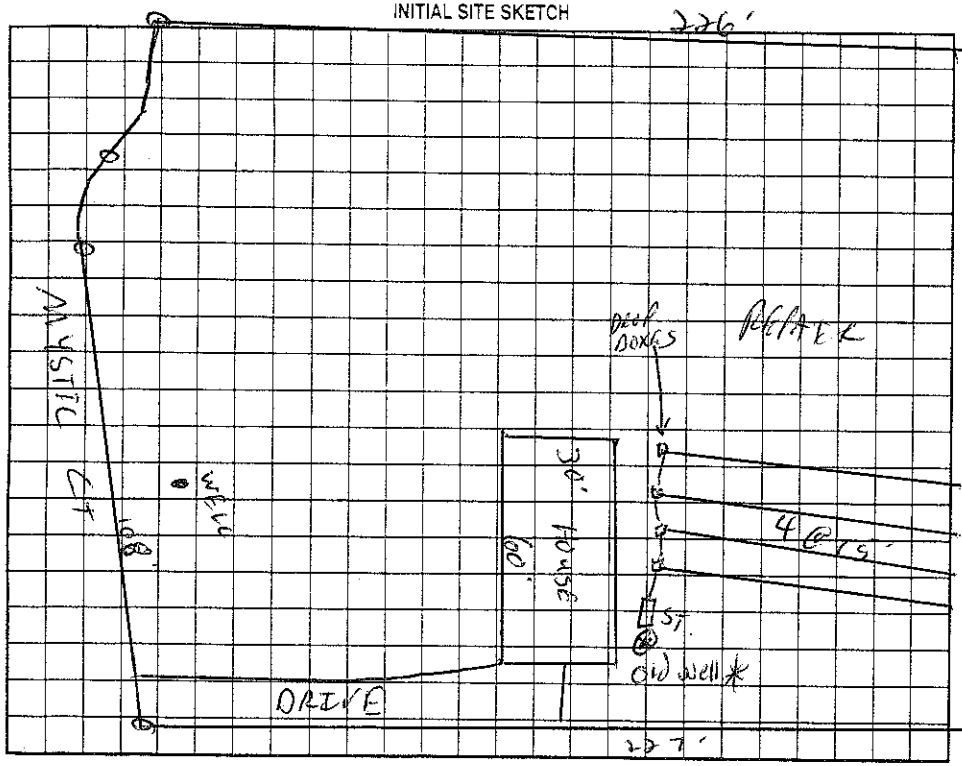

AS BUILT SKETCH

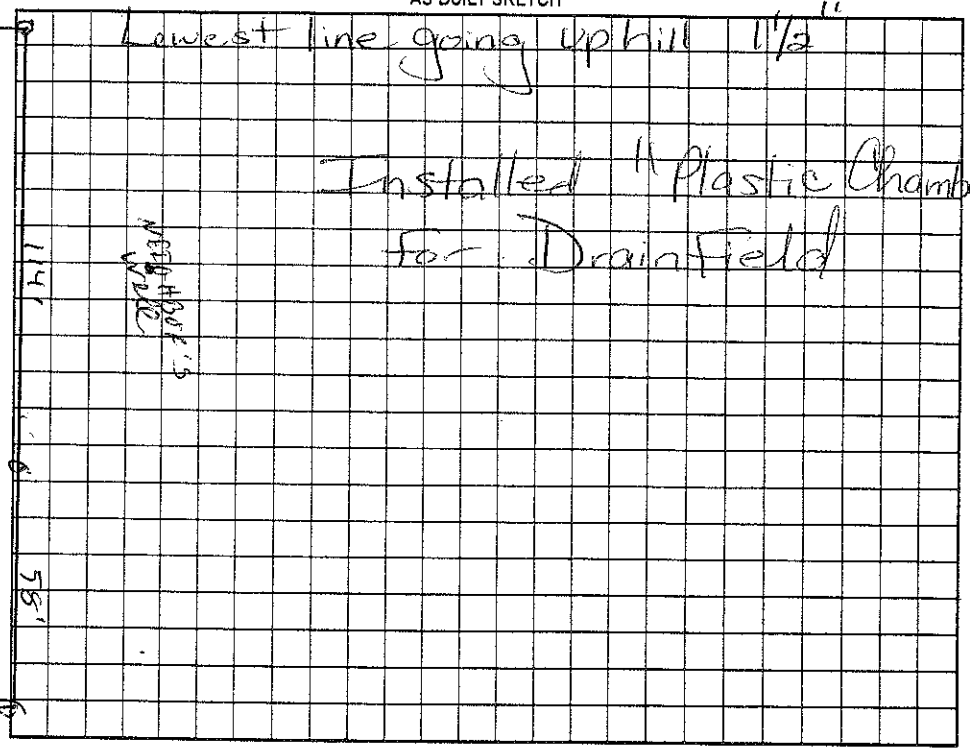

Permit can be suspended or revoked if any false information is supplied toward securing the permit/any unauthorized changes are made to the site/any unauthorized changes are made in the installation of the system. Improvement Permit with plat valid without expiration. Improvement Permit with site plan valid for sixty months. Authorization to Construct is valid for a period equal to that of Improvement Permit – not to exceed sixty months.

Signed: date 1-24-04 Installed by: Craig Thompson

Improvement Permit by: date 10/24/03 Operation Permit by: Mandy H. Dotson B.S. date 5/12/04

Authorization to Construct by: date 4/21/04 Existing System Inspection by: date

HEALTH DEPT. COPY: WHITE OWNER COPY (FINAL): YELLOW OWNER COPY (INITIAL): PINK