IREDELL COUNTY HEALTH DEPARTMENT

Statesville Office (704) 878-5305 Mooresville Office (704) 660-3625 PERMIT # 217033

IMPROVEMENT PERMIT / AUTHORIZATION TO CONSTRUCT / OPERATION PERMIT / EXISTING SYSTEM

PIN # 4649756118 ✓

APPLICANT: Darrell Williams APPLICANT ADDRESS: 122 Mystic Court

SITE ADDRESS: 122 Mystic Court PHONE: 980-613-9258 ALT. PHONE: N/A

SITE DIRECTIONS: Hwy 115 to Flowerhouse LP TL Rankinhill TL Magic Forest TR Mystic Ct

SUBDIVISION: Magic Forest SECTION: P4 LOT # 32 LOT AREA: 0.96 acres DESIGN FLOW: Existing L.T.A.R.: Existing


Septic Tank	Existing (gal)	STB	Date	☐ New System ☐ Repair ☐ Expansion	System Type: I II III IV V VI	☑ Residence	No. Bedrooms Ex
Pump Tank	(gal)	PT	Date	System Description: Existing		☐ Business	No. Persons Ex
Pump Make	Model		Serial #	Repair System Description:		☐ Other	No. Employees
# Nitrification Fields Ex	# Lines Ex		Linear Ft: Ex	Maintenance Agreement Required:	☐ YES ☑ NO	☐ Slab	☑ Crawl Space
Trench Width Ex	Max. Trench Bottom Depth Ex		Gravel Depth Ex	☑ GRAVITY	☐ PRESSURE	☐ Basement w/plumbing	☐ Basement w/o plumbing

Water Supply: ☑ Private ☐ Public ☐ Community


Comments / Conditions:

Maintain a minimum of 5' between building foundation & all components of septic system & septic repair area.

INITIAL SITE SKETCH

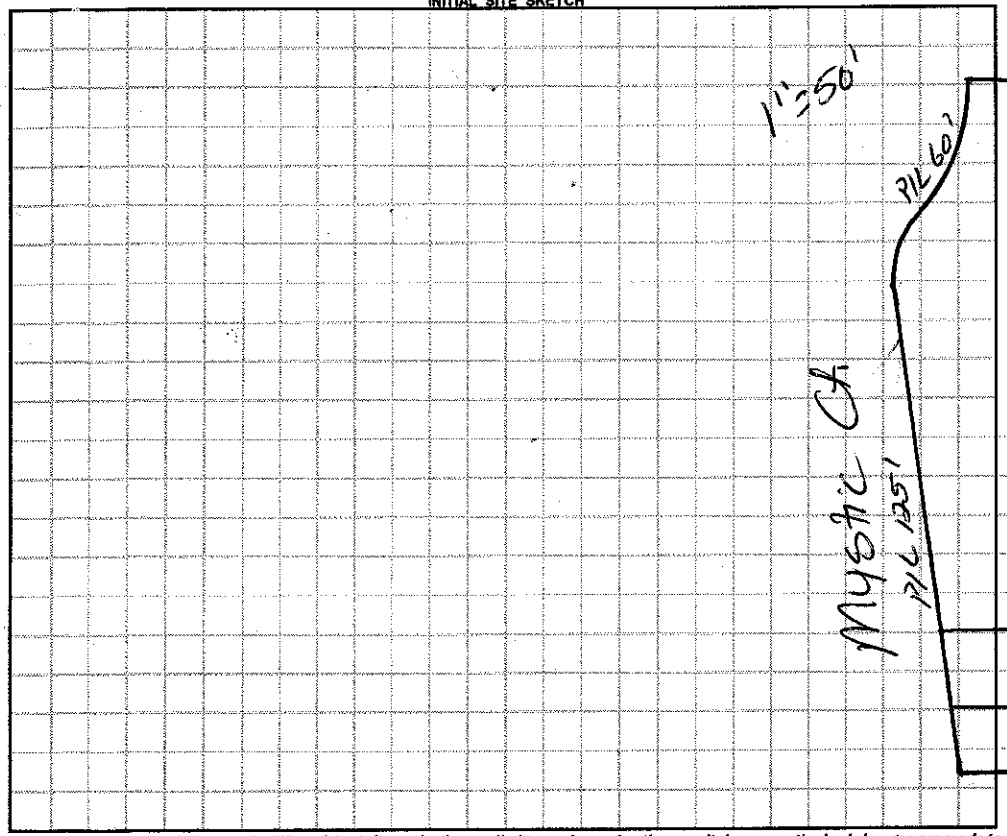

AS BUILT SKETCH

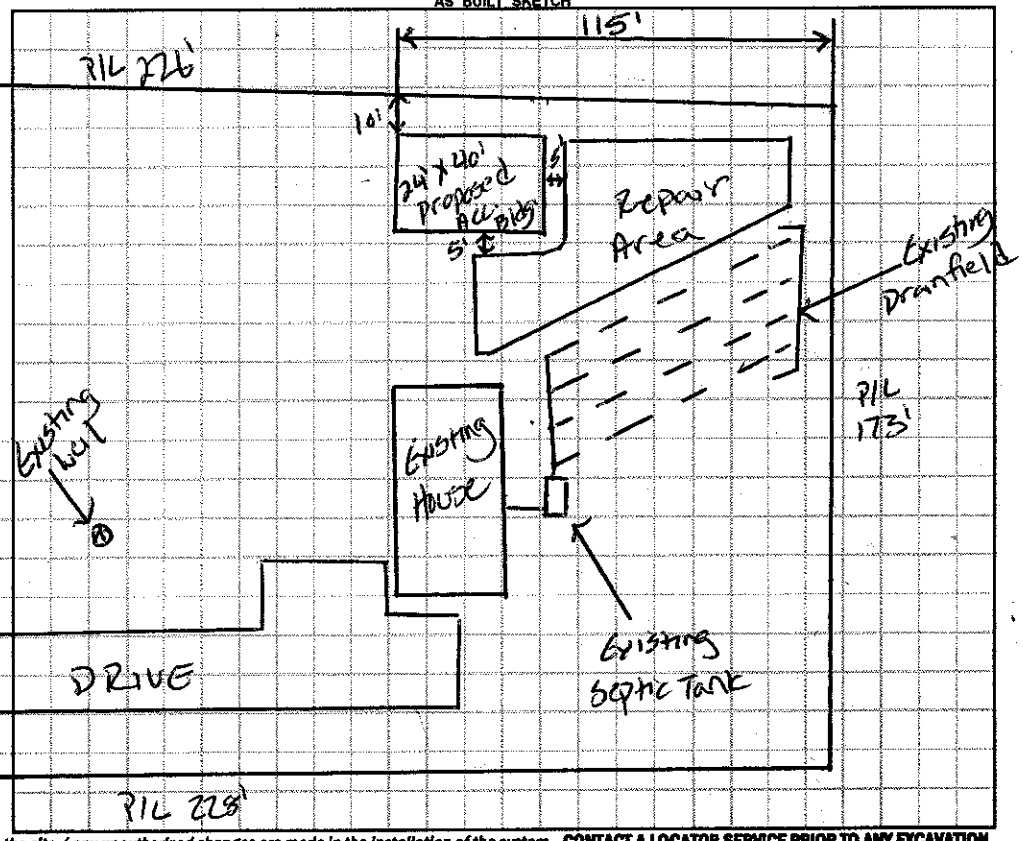

Permit can be suspended or revoked if any false information is supplied toward securing the permit / any unauthorized changes are made to the site / any unauthorized changes are made in the installation of the system. **CONTACT A LOCATOR SERVICE PRIOR TO ANY EXCAVATION**

☐ **IMPROVEMENT PERMIT** *with plat valid without expiration.* ☐ **IMPROVEMENT PERMIT** *with site plan valid for 60 mos.* ☐ **AUTHORIZATION TO CONSTRUCT** *valid for period equal to IMPROVEMENT PERMIT--not to exceed 60 mo.*

Owner / Applicant Signature: Darrell D. Williams Jr. Date: 4/8/16 Installed by:

IMPROVEMENT PERMIT by: Date: OPERATION PERMIT by: Date:

AUTHORIZATION TO CONSTRUCT by: Date: Existing System Inspected by: Date: 4/8/16

Health Dept. Copy - WHITE Applicant (Final Approval) - YELLOW Applicant (Conditional Approval) - PINK