IREDELL COUNTY HEALTH DEPARTMENT

STATESVILLE 704-878-5305 $130 MOORESVILLE 704-664-5281

IMPROVEMENT PERMIT / AUTHORIZATION TO CONSTRUCT / OPERATION PERMIT / EXISTING SYSTEM INSPECTION

PERMIT# 111877 PIN# ~~4649-75-0165.36~~ 4649-75-7583 DATE 5/4/05

OWNER OR CONTRACTOR ~~PRIMESTAR PROPERTIES~~ EXPRESSION HOMES Business 932-9100 Home

ADDRESS 1709 S MAIN ST. KANNAPOLIS, NC 28081

LOCATION 21(N) - TL FLOWER HOUSE - TL RANKIN HILL - TL MAGIC FOREST - TR MYSTIC CT. - ON LT.

SUBDIVISION MAGIC FOREST BLOCK / SECTION 4 LOT 38 LOT AREA 1.01 AC SITE CLASS: PS DESIGN FLOW #360 GPD L.T.A.R. .36PD/FT

Septic Tank: 1000 Gallons; STB 760 Date 2/7/05

Pump Tank: Gallons; PT Date

Pump Make: Model Serial No.

Nitrification Field: No Fields 1 Square Feet 900 Linear Feet 300

No Lines 4@75" Trench Width 36" Max Trench Bottom Depth 36" Gravel Depth #57

☑ New System ☐ Repair System Type: I, II, (III), IV, V, VI

System Description: GRAVITY 25% REDUCTION

Repair System Description: SAME

Maintenance Agreement Required: ☐ Yes ☑ No

☑ House/Mod. Home No. Bedrooms 3

☐ Mobile Home No. Bathrooms 3

☐ Business No. Employees

☐ Other


☐ Slab ☑ Crawl Space ☐ Basement w/plumbing ☐ Basement wo/plumbing

Water Supply: ~~☐ Individual~~ ☐ Public ☐ Community


Comments:/Conditions:

Comments:/Conditions:

INITIAL SITE SKETCH 1"=50'

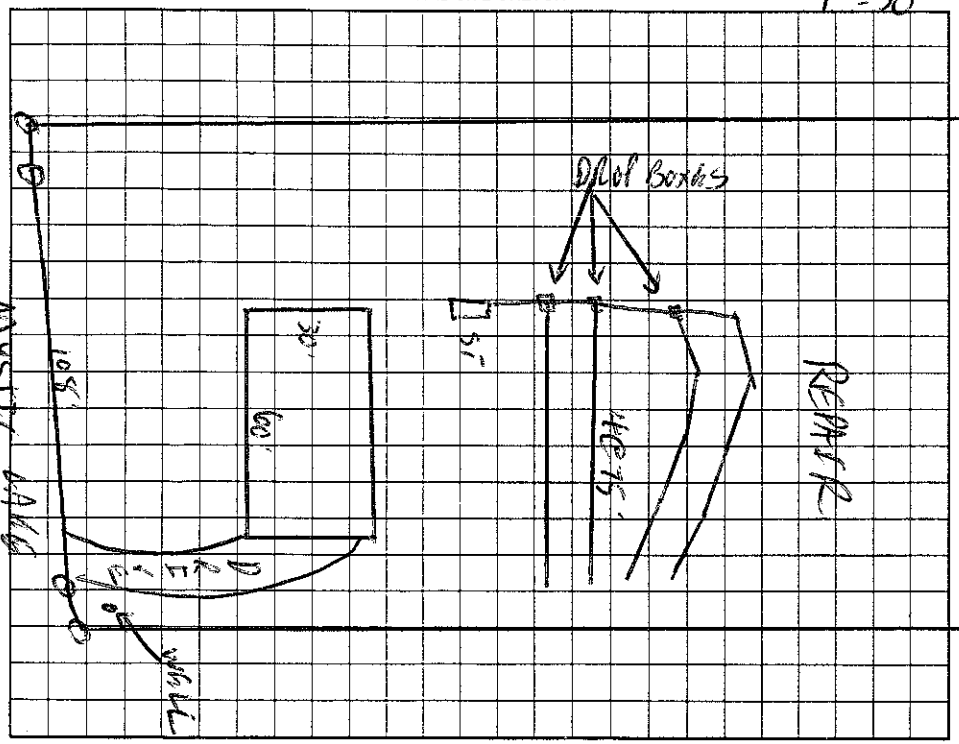

AS BUILT SKETCH

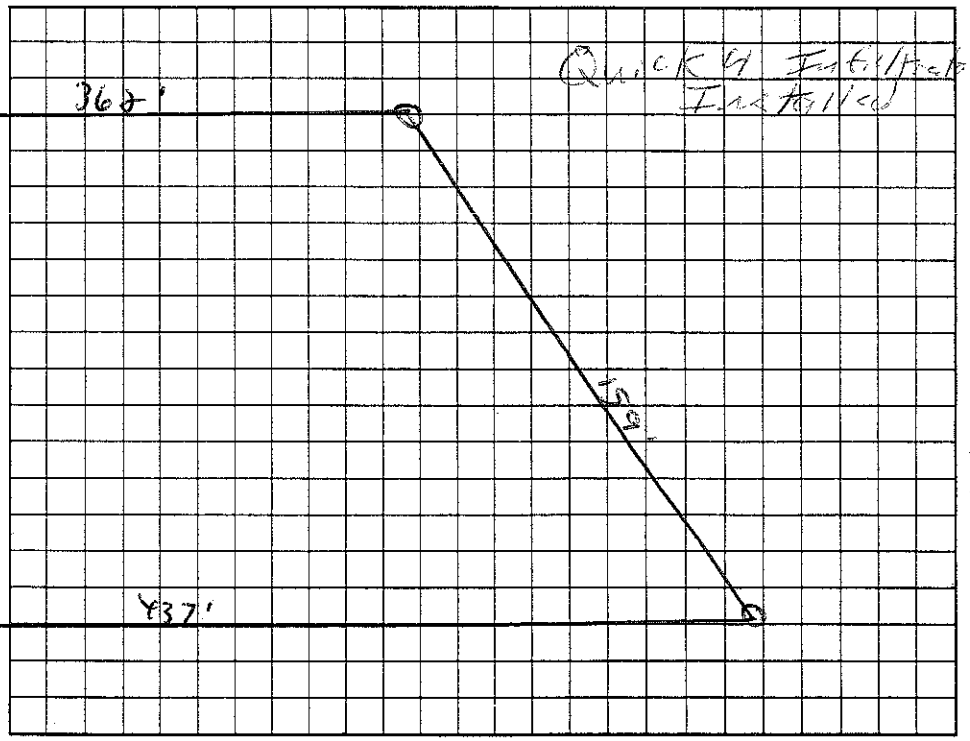

Permit can be suspended or revoked if any false information is supplied toward securing the permit/any unauthorized changes are made to the site/any unauthorized changes are made in the installation of the system. Improvement Permit with plat valid without expiration. Improvement Permit with site plan valid for sixty months. Authorization to Construct is valid for a period equal to that of Improvement Permit – not to exceed sixty months.

Signed: date 5-5-05 Installed by: Craig Thompson

Improvement Permit by: RS date 5/4/05 Operation Permit by: RS date 5/12/05

Authorization to Construct by: Wesley Sparks RS date 5/9/05 Existing System Inspection by: date

HEALTH DEPT. COPY: WHITE OWNER COPY (FINAL): YELLOW OWNER COPY (INITIAL): PINK