IREDELL COUNTY HEALTH DEPARTMENT

STATESVILLE 704-878-530[illegible] MOORESVILLE 704-664-5281

IMPROVEMENT PERMIT / AUTHORIZATION TO CONSTRUCT / OPERATION PERMIT / EXISTING SYSTEM INSPECTION

PERMIT# 111878 PIN# 4649-75-8181 DATE 9/28/05

OWNER OR CONTRACTOR Pinnastar Properties PHONE: Business 704 932 900 Home

ADDRESS 1709 S. Main St. Kannapolis NC 28081

LOCATION 115 N, TL Flowerhouse, TL Rankin Hill, TL Magic Forest TR Mystic Ct, at End on Lt

SUBDIVISION Magic Forest BLOCK / SECTION 4 LOT 39 LOT AREA 1.334c SITE CLASS PS DESIGN FLOW 480 L.T.A.R. 0.3

Septic Tank: 1000 Gallons; STB 1007 Date 2/14/06

Pump Tank: Gallons; PT Date

Pump Make: Model Serial No.

Nitrification Field: No Fields 1 Square Feet 1200 Linear Feet 400

No Lines 5@30' Trench Width 36" Max Trench Bottom Depth 36" Gravel Depth —

☒ New System ☐ Repair System Type: I, II, III, IV, V, VI

System Description: Gravity 25% Reduct.

Repair System Description: Same

Maintenance Agreement Required: ☐ Yes ☒ No

☐ House/Mod. Home ☒ Mobile Home ☐ Business ☐ Other

No. Bedrooms 4 No. Bathrooms No. Employees


☐ Slab ☒ Crawl Space ☐ Basement w/plumbing ☐ Basement wo/plumbing

Water Supply: ☒ Individual ☐ Public ☐ Community


Comments:/Conditions:

Comments:/Conditions:

INITIAL SITE SKETCH

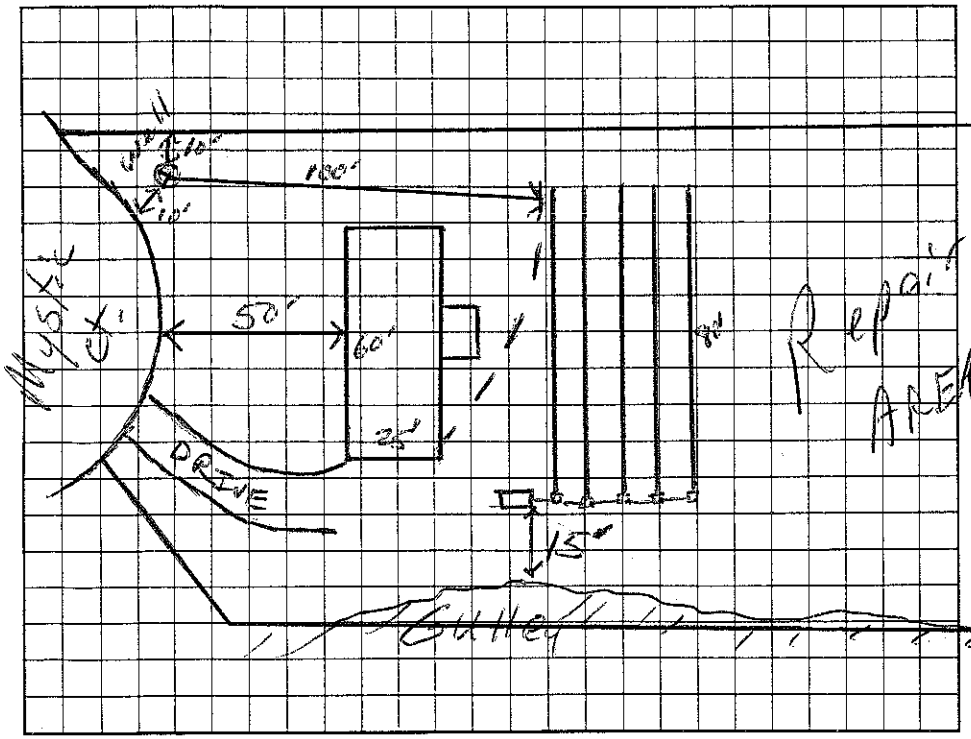

AS BUILT SKETCH

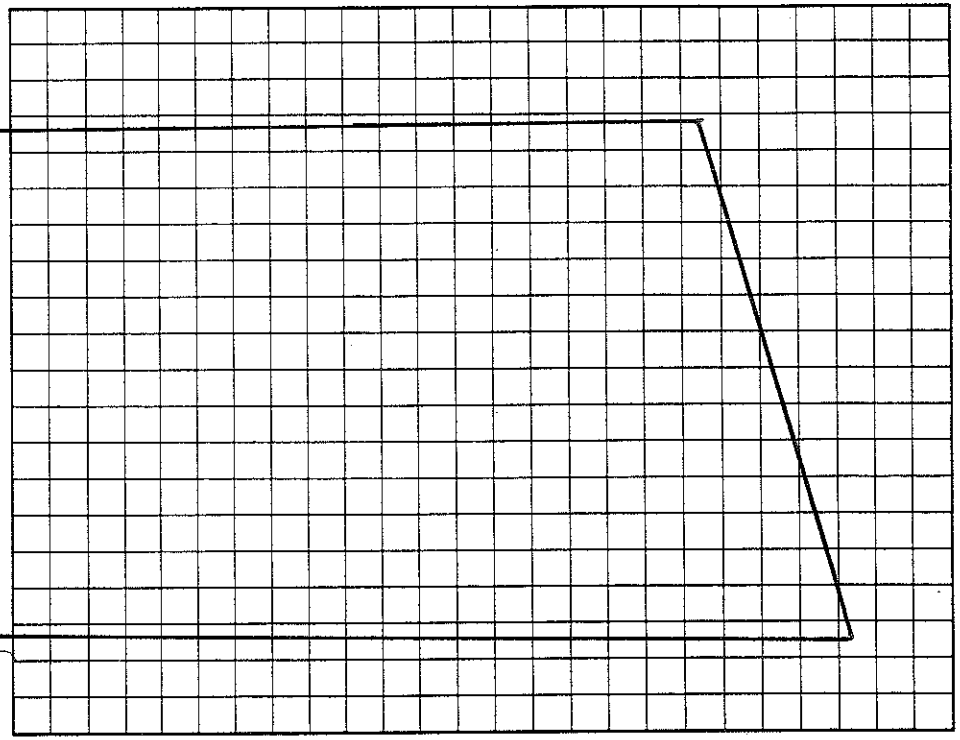

Permit can be suspended or revoked if any false information is supplied toward securing the permit/any unauthorized changes are made to the site/any unauthorized changes are made in the installation of the system. Improvement Permit with plat valid without expiration, Improvement Permit with site plan valid for sixty months. Authorization to Construct is valid for a period equal to that of Improvement Permit – not to exceed sixty months.

Signed: Brent Kennedy date

Improvement Permit by: RS date 9/28/05

Authorization to Construct by: RS date 9/28/05

Installed by: K + M Grading

Operation Permit by: RS date 4/13/06

Existing System Inspection by: date

HEALTH DEPT. COPY: WHITE OWNER COPY (FINAL): YELLOW OWNER COPY (INITIAL): PINK