IREDELL COUNTY HEALTH DEPARTMENT

STATESVILLE 704-878-5305 MOORESVILLE 704-664-5281

IMPROVEMENT PERMIT / AUTHORIZATION TO CONSTRUCT / OPERATION PERMIT / EXISTING SYSTEM INSPECTION

PERMIT# 070968 PIN# 4649750474 PT DATE 1/6/98

OWNER OR CONTRACTOR EASYWAY INC PHONE: Business 663-2220 Home

ADDRESS PO BOX 733 MOORESVILLE NC 28115

LOCATION 21/115N - TL FLOWERHOUSE - TL RANKENHILL - ON RT JUST PAST PALOMINO PARK ENTRANCE

SUBDIVISION — BLOCK / SECTION — LOT — LOT AREA 1.13 AC SITE CLASS. PS DESIGN FLOW 360GPD L.T.A.R. .30GPD/FT

Septic Tank: 1000 Gallons; STB 821 Date 2/25/98

Pump Tank: Gallons; PT Date

Pump Make: Model Serial No.

Nitrification Field: No Fields 1 Square Feet 1200 Linear Feet 400

No Lines 4@100' Trench Width 36" Max Trench Bottom Depth 36" Gravel Depth 12"

☑ New System ☐ Repair System Type: I (II) III, IV, V, VI

System Description: GRAVITY CONVENTIONAL

Repair System Description: GRAVITY CHAMBER/GARDIUS

Maintenance Agreement Required: ☐ Yes ☑ No

☑ House/Mod. Home No. Bedrooms 3

☑ Mobile Home No. Bathrooms 2

☐ Business No. Employees

☐ Other


☐ Slab ☑ Crawl Space ☐ Basement w/plumbing ☐ Basement wo/plumbing

Water Supply: ☑ Individual ☐ Public ☐ Community

Comments:/Conditions:

Comments:/Conditions: 4@75'x3' Chem. Plastic Installed

INITIAL SITE SKETCH 1" = 60'

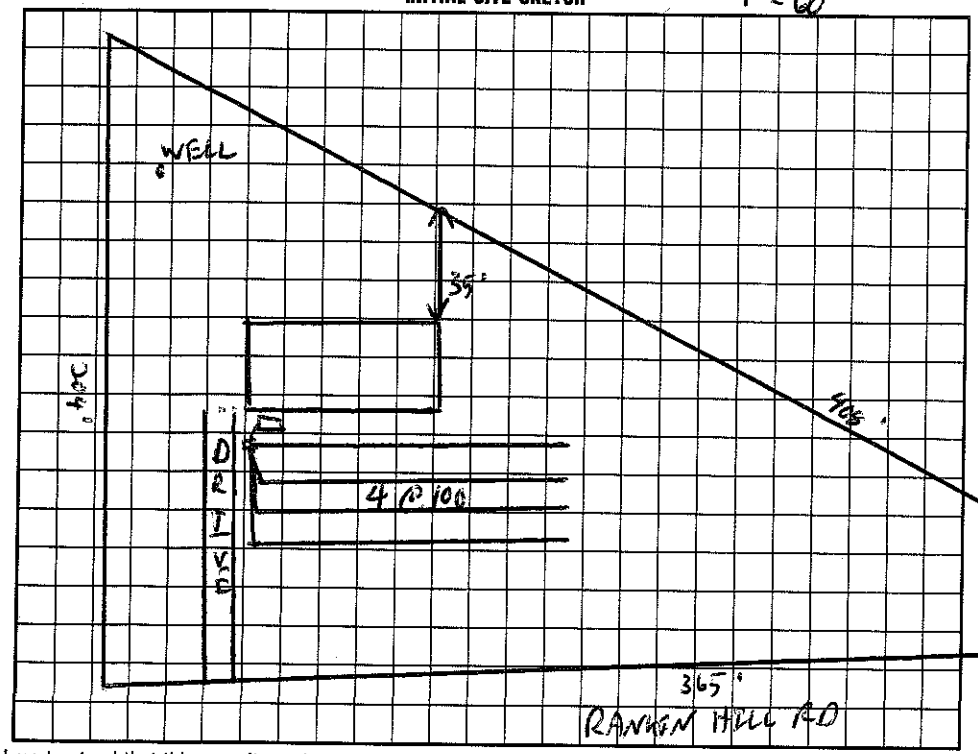

AS BUILT SKETCH

I understand that this permit can be suspended or revoked if any false information is supplied toward securing the permit/any unauthorized changes are made to the site/any unauthorized changes are made in the installation of the system. Improvement Permit with plat valid without expiration. Improvement Permit with site plan valid for sixty months. Authorization to Construct is valid for a period equal to that of Improvement Permit – not to exceed sixty months.

Signed: date

Improvement Permit by: C. [signature] date 1/6/98

Authorization to Construct by: C. [signature] date 1/6/98

Installed by: B & M Enterprises

Operation Permit by: Wesley Sparks RS date 4/13/98

Existing System Inspection by: Wesley Sparks RS date 4/13/98

HEALTH DEPT. COPY: WHITE INSPECTION COPY (FINAL): GREEN OWNER COPY (FINAL): YELLOW INSPECTION COPY (INITIAL): PINK OWNER COPY (INITIAL): GOLD