4649762621

IREDELL COUNTY HEALTH DEPARTMENT

STATESVILLE 704-878-5305 MOORESVILLE 704-~~664-5281~~

IMPROVEMENT PERMIT / AUTHORIZATION TO CONSTRUCT / OPERATION PERMIT / EXISTING SYSTEM INSPECTION

PERMIT# 075820 PIN# ~~4649 66 7891~~ DATE 10/7/98

OWNER OR CONTRACTOR Piedmont Housing #9 PHONE: Business 483-1128 Home

ADDRESS 4879 N. Hwy 16 Denver, NC. 28037

LOCATION Rankin Hill Rd to last 2 lots on (L) before Thoroughbred Drive

SUBDIVISION Westwinds BLOCK / SECTION 1 LOT ~~13~~ 14 LOT AREA 0 ac 1.04 SITE CLASS. RS DESIGN FLOW 360 L.T.A.R. e.35

Septic Tank: 1000 Gallons; STB 824 Date 9/14/98
Pump Tank: Gallons; PT Date
Pump Make: Model Serial No.
Nitrification Field: No Fields 1 Square Feet 1197 Linear Feet 400
No Lines 30@33x3 Trench Width 36" Max Trench Bottom Depth 30" Gravel Depth SAND

[X] New System [ ] Repair System Type: I, II, (III) IV, V, VI
System Description: Brentwood-CH. PLASTIC
Repair System Description: Pressure Panel
Maintenance Agreement Required: [ ] Yes [X] No

[X] House/Mod. Home No. Bedrooms 3
[ ] Mobile Home No. Bathrooms 3
[ ] Business No. Employees
[ ] Other
[ ] Slab [X] Crawl Space [ ] Basement w/plumbing [ ] Basement wo/plumbing


Water Supply: [X] Individual [ ] Public [ ] Community

Comments/Conditions:


(1" = 50')

Comments:/Conditions:

INITIAL SITE SKETCH

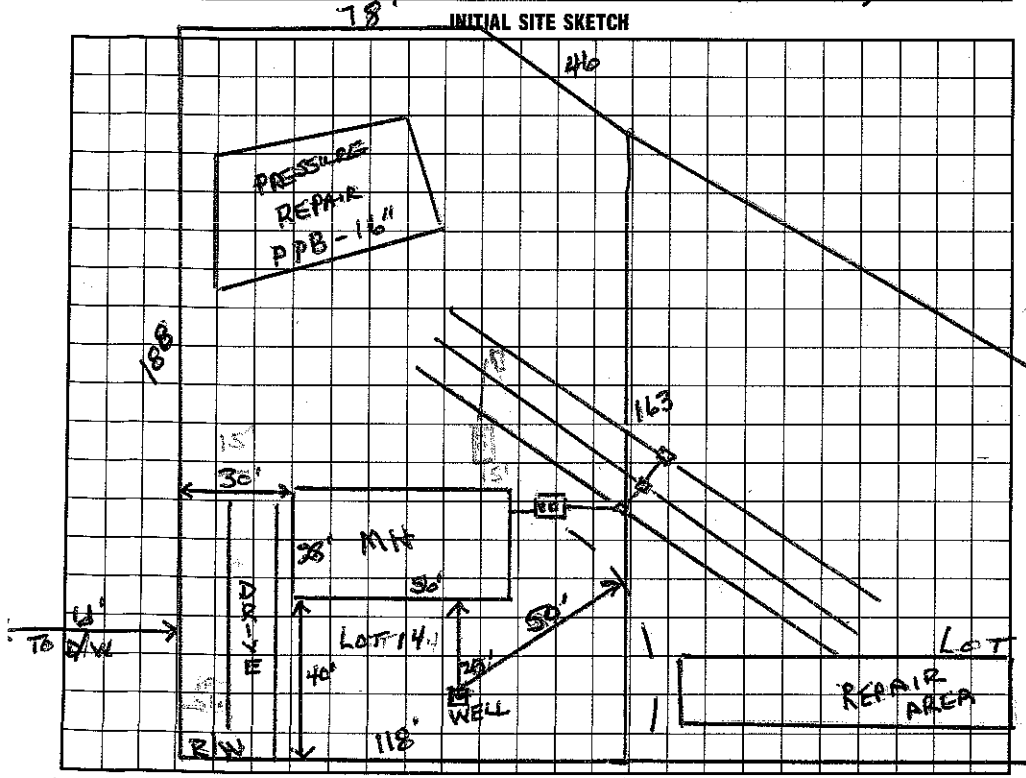

AS BUILT SKETCH

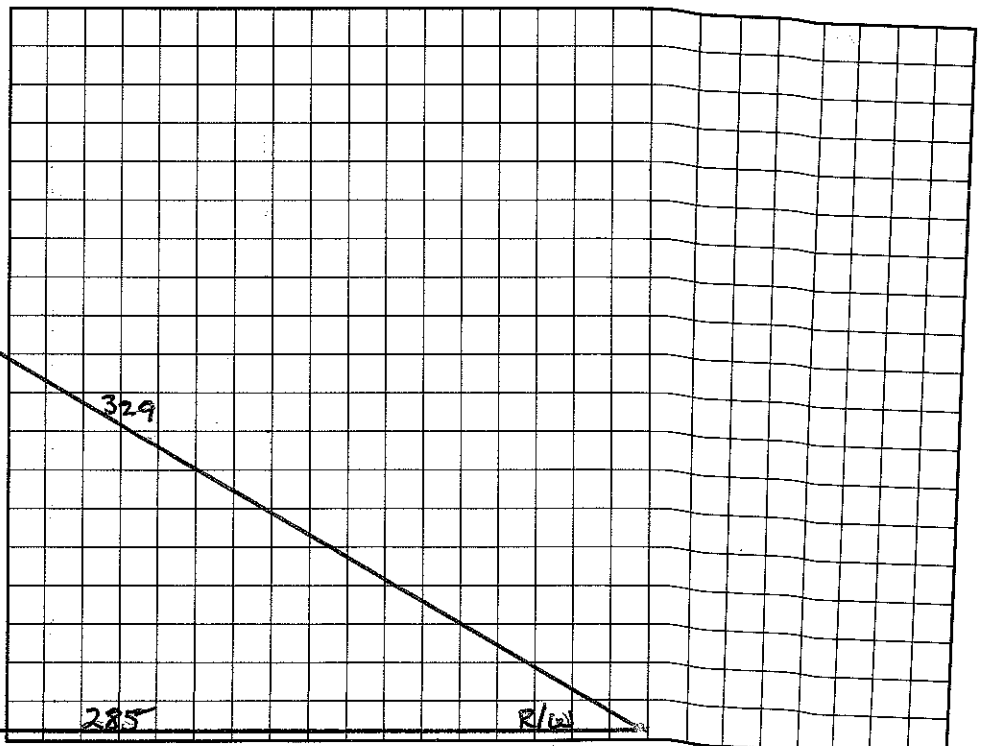

I understand that this permit can be suspended or revoked if any false information is supplied toward securing the permit/any unauthorized changes are made to the site/any unauthorized changes are made in the installation of the system. Improvement Permit with plat valid without expiration. Improvement Permit with site plan valid for sixty months. Authorization to Construct is valid for a period equal to that of Improvement Permit – not to exceed sixty months.

RANKIN HILL RD.

Signed: [signature] date 10-9-98 Installed by: O & M ENTERPRISES

Improvement Permit by: Wesley Sparks R.S. date 10/7/98 Operation Permit by: C. [signature] date 10/14/98

Authorization to Construct by: Wesley Sparks R.S. date 10/7/98 Existing System Inspection by: date

HEALTH DEPT. COPY: WHITE INSPECTION COPY (FINAL): GREEN OWNER COPY (FINAL): YELLOW INSPECTION COPY (INITIAL): PINK OWNER COPY (INITIAL): GOLD