IREDELL COUNTY HEALTH DEPARTMENT

...ESVILLE 704-878-5305 MOORESVILLE 704-664-5281

IMPROVEMENT PERMIT / AUTHORIZATION TO CONSTRUCT / OPERATION PERMIT / EXISTING SYSTEM INSPECTION

PERMIT# 074113 PIN# 4649 66 7891 (PT) 4649 76 2722 DATE 7/16/98

OWNER OR CONTRACTOR Wm L. Heafner PHONE: Business 736-4331 Home

ADDRESS PO Box 1732 Lincolnton, NC. 28093

LOCATION Rankin Hill Rd - 11.5 N TL 1st Flower House Loop TL Rankin Hill, 3rd on (L) before Thoroughbred Drive.

SUBDIVISION Westwinds BLOCK / SECTION 1 LOT 15 LOT AREA .50 SITE CLASS. P's DESIGN FLOW 360 L.T.A.R. .3

Septic Tank: 1000 Gallons; STB 1012 Date 5/18/98
Pump Tank: 1000 Gallons; PT 27 Date 2/19/98
Pump Make: HYDROMATIC Model SK50M1 Serial No. 6/98
Nitrification Field: No Fields 1 Square Feet 600* Linear Feet 200*
No Lines 4 Trench Width 36" Max Trench Bottom Depth 32" Gravel Depth SAND

[X] New System [ ] Repair System Type: I, II, III, IV, V, VI
System Description: Pres Prefab. Panels
Repair System Description: Same
Maintenance Agreement Required: [X] Yes [ ] No


[X] House/Mod. Home No. Bedrooms 3
[ ] Mobile Home No. Bathrooms 3
[ ] Business No. Employees
[ ] Other
[ ] Slab [X] Crawl Space [ ] Basement w/plumbing [ ] Basement wo/plumbing

Water Supply: [X] Individual [ ] Public [ ] Community


Comments/Conditions: One 3/16" hole per panel turned up.
23-25GPM - 110GALS/DOSE
2' PRESSURE HEAD PER LATERAL

Comments/Conditions:

INITIAL SITE SKETCH

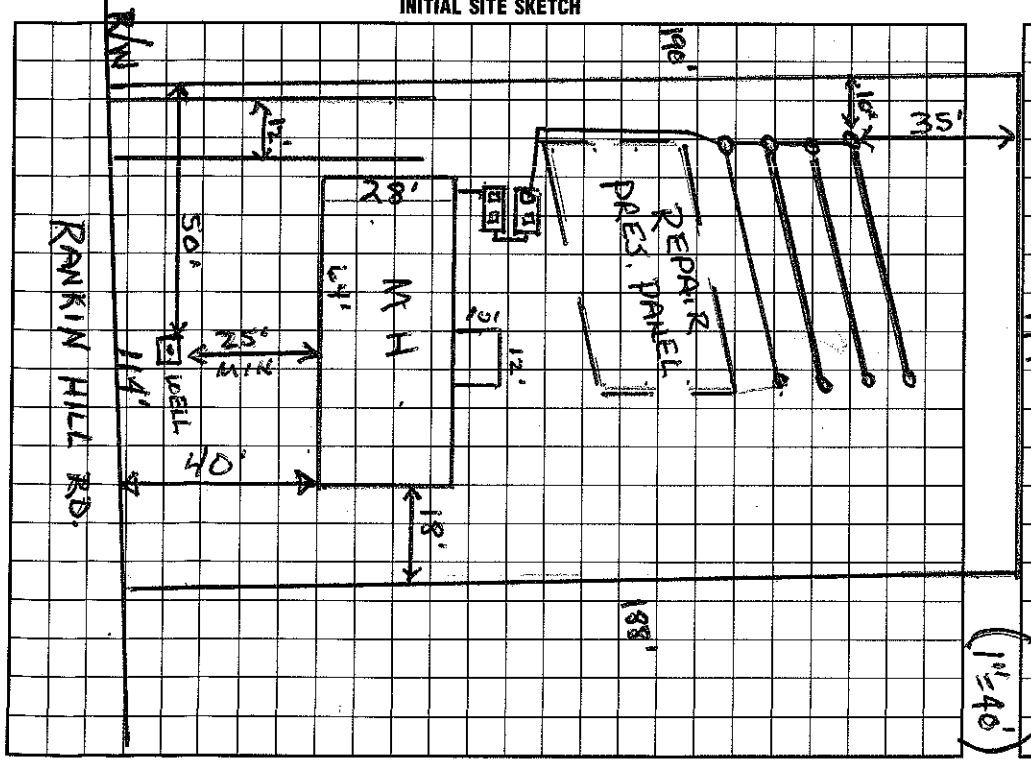

AS BUILT SKETCH

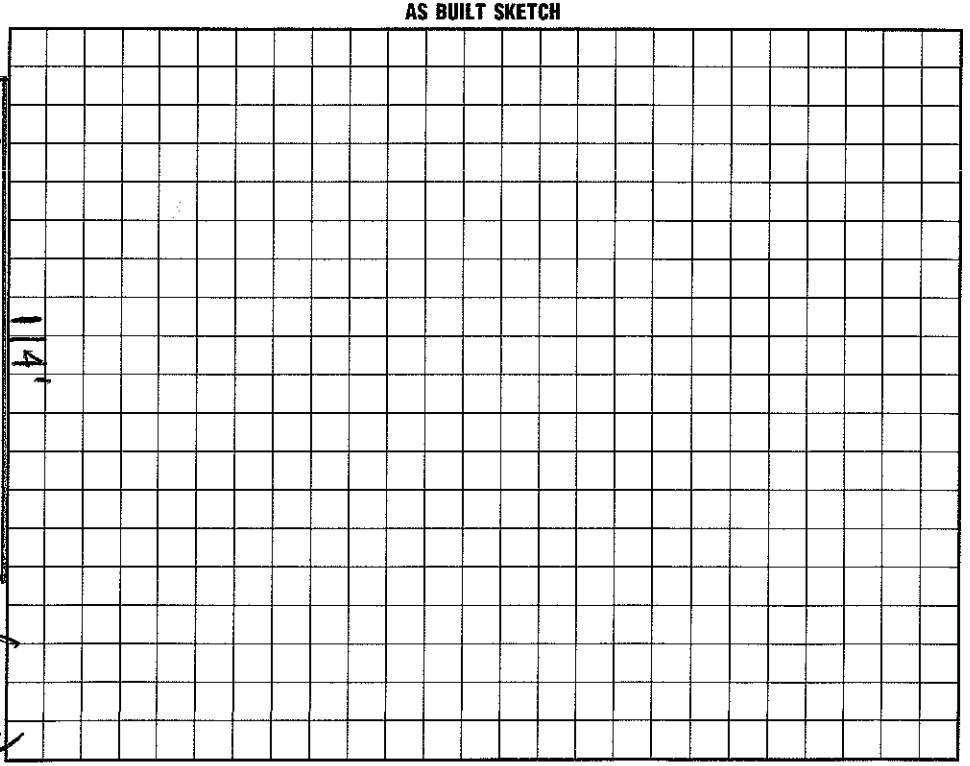

I understand that this permit can be suspended or revoked if any false information is supplied toward securing the permit/any unauthorized changes are made to the site/any unauthorized changes are made in the installation of the system. Improvement Permit with plat valid without expiration. Improvement Permit with site plan valid for sixty months. Authorization to Construct is valid for a period equal to that of Improvement Permit – not to exceed sixty months.

Signed: [signature] date

Improvement Permit by: Wesley Sparks RS. date 7/16/98

Authorization to Construct by: Wesley Sparks RS. date 7/16/98

Installed by: Dennis Bridges

Operation Permit by: [signature] date 8/25/98

Existing System Inspection by: date

HEALTH DEPT. COPY: WHITE INSPECTION COPY (FINAL): GREEN OWNER COPY (FINAL): YELLOW INSPECTION COPY (INITIAL): PINK OWNER COPY (INITIAL): GOLD