IREDELL COUNTY HEALTH DEPARTMENT

AUTHORIZATION TO CONSTRUCT

784-3019 - Bridges

STATESVILLE 704-878-5305 MOORESVILLE 704-664-5281

IMPROVEMENT PERMIT / ~~CERTIFICATE OF COMPLETION~~ / OPERATION PERMIT / EXISTING SYSTEM INSPECTION

PROPERTY DESCRIPTION NO. 23118 DATE 11/21/96 TAX MAP NO. 4E-3-A-64 Watershed: ☑ Yes ☐ No

OWNER OR CONTRACTOR ~~MELODY~~ MELODY SELLERS PHONE: Business 4649-76-3494 Home 528-3805

ADDRESS 183 THOROUGHBRED DR TROUTMAN NC 28166

LOCATION HWY 21/115 N - TL FLOWERHOUSE LOOP TR RANKIN HILL - TL THOROUGHBRED - TL SORREL - 3RD LOT ON LEFT

SUBDIVISION PALOMINO PARK BLOCK / SECTION _____ LOT 64 LOT AREA _____ SITE CLASS. PS DESIGN FLOW 360GPD L.T.A.R. 360GPD

Septic Tank: 1000 Gallons; STB 794 Date 10/1/96

Pump Tank: _____ Gallons; PT _____ Date _____

Pump Make: _____ Model _____ Serial No. _____

Nitrification Field: No Fields 1 Square Feet 1200 Linear Feet 400

No Lines 3 Trench Width 36" Max Trench Bottom Depth 36+

☑ New System ☐ Repair System Type: I (II) III, IV, V, VI

System Description: GRAVITY CONVENTIONAL

Repair System Description: GRAVITY CHAMBERED OR SEMICON

Maintenance Agreement Required: ☐ Yes ☑ No

Gravel Depth 12"

☐ House/Mod. Home No. Bedrooms 3

☑ Mobile Home No. Bathrooms 2

☐ Business No. Employees ____

☐ Other _____


☐ Slab ☑ Crawl Space ☐ Basement w/plumbing ☐ Basement wo/plumbing

Water Supply:
☑ Individual
☐ Community
☐ Public


Comments:

Comments:

INITIAL SITE SKETCH

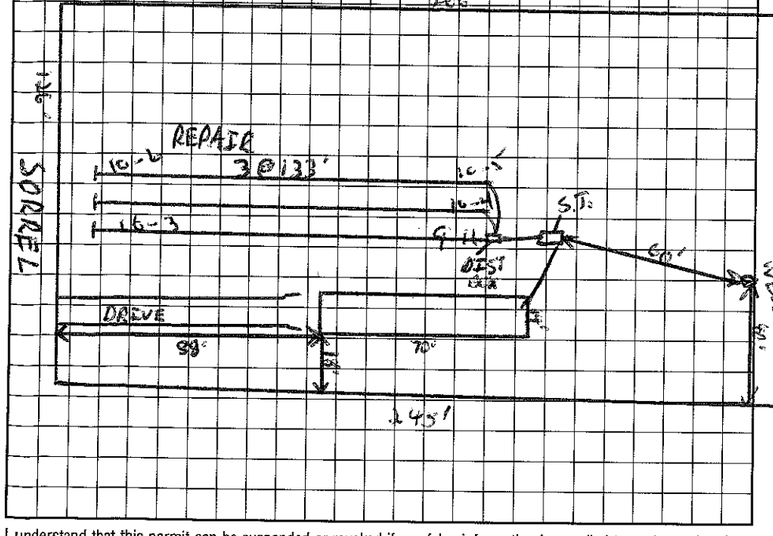

AS BUILT SKETCH

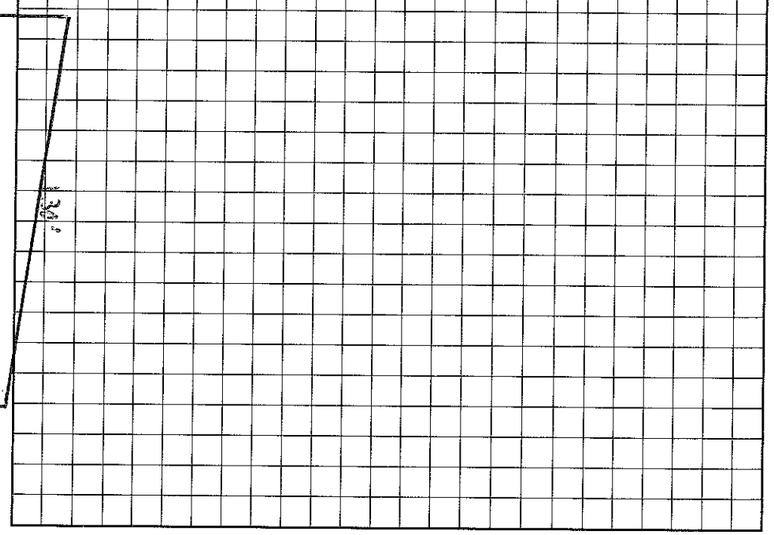

I understand that this permit can be suspended or revoked if any false information is supplied toward securing the permit/any unauthorized changes are made to the site/any unauthorized changes are made in the installation of the system.

Signed: Robert Jones

Improvement Permit by: C. Bridges EHS date 11/21/96

~~Existing System Inspection by:~~ AUTHORIZATION TO CONSTRUCT C. Bridges EHS date 11/21/96

Installed by: Chip Bridges

Certificate of Completion by: _____ date _____

Operation Permit by: Wesley Sparks R.S. date 12/18/96

HEALTH DEPT. COPY: WHITE INSPECTION COPY (FINAL): GREEN OWNER COPY (FINAL): YELLOW INSPECTION COPY (INITIAL): PINK OWNER COPY (INITIAL): GOLD