IREDELL COUNTY HEALTH DEPARTMENT

Authorization to Construct

STATESVILLE 704-878-5305 MOORESVILLE 704-664-5281

IMPROVEMENT PERMIT / ~~CERTIFICATE OF COMPLETION~~ / OPERATION PERMIT / EXISTING SYSTEM INSPECTION

PROPERTY DESCRIPTION NO. 23575 DATE 6/6/96 TAX MAP NO. 4E-3A-71 Watershed: ☑ Yes ☐ No

OWNER OR CONTRACTOR Billy & Lillie Miller PHONE: Business 4649-76-8617 Home 663-7566

ADDRESS PO Box 174 Troutman 28166

LOCATION 215 TR Flowerhouse Loop i/L Rankinhill Rd, i/L Thoroughbred Dr. i/L Sorrel Lane 3rd lot on RC

SUBDIVISION Palomino Park BLOCK / SECTION LOT 71 LOT AREA ± .75 ac SITE CLASS. PS DESIGN FLOW 360 gpd L.T.A.R. .3 gal/ft²

Septic Tank: 1000 Gallons; STB 194 Date 5/21/96

Pump Tank: Gallons; PT Date

Pump Make: Model Serial No.

Nitrification Field: No Fields 1 Square Feet 1200 Linear Feet 400

No Lines 4 Trench Width 36" Max Trench Bottom Depth 36" Gravel Depth 12"

☑ New System ☐ Repair System Type: I II III IV V VI

System Description: Gravity Conventional

Repair System Description: Chamberex

Maintenance Agreement Required: ☐ Yes ☐ No

☐ House/Mod. Home ☑ Mobile Home ☐ Business ☐ Other

No. Bedrooms 3 No. Bathrooms 2 No. Employees


☐ Slab ☑ Crawl Space ☐ Basement w/plumbing ☐ Basement wo/plumbing

Water Supply: ☑ Individual ☐ Community ☐ Public


Comments:

Comments:

INITIAL SITE SKETCH 1" = 40'

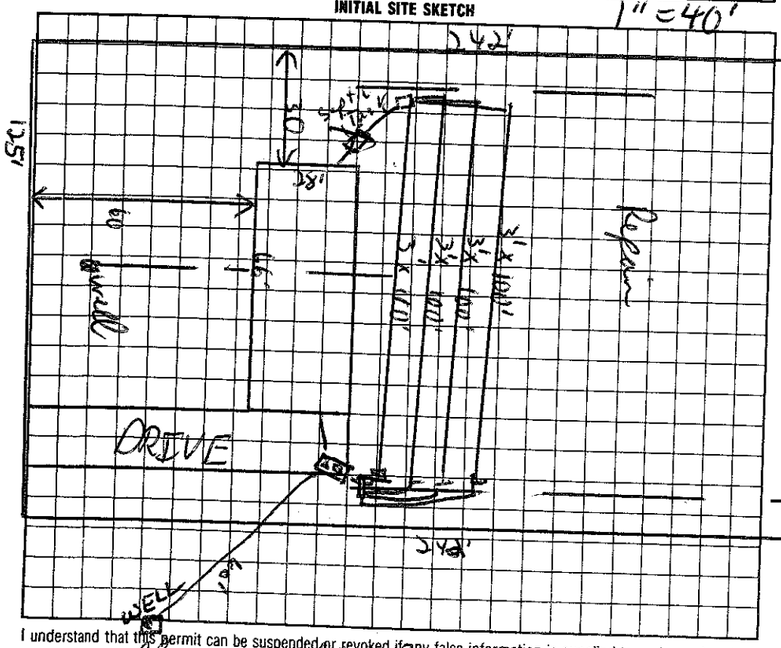

AS BUILT SKETCH

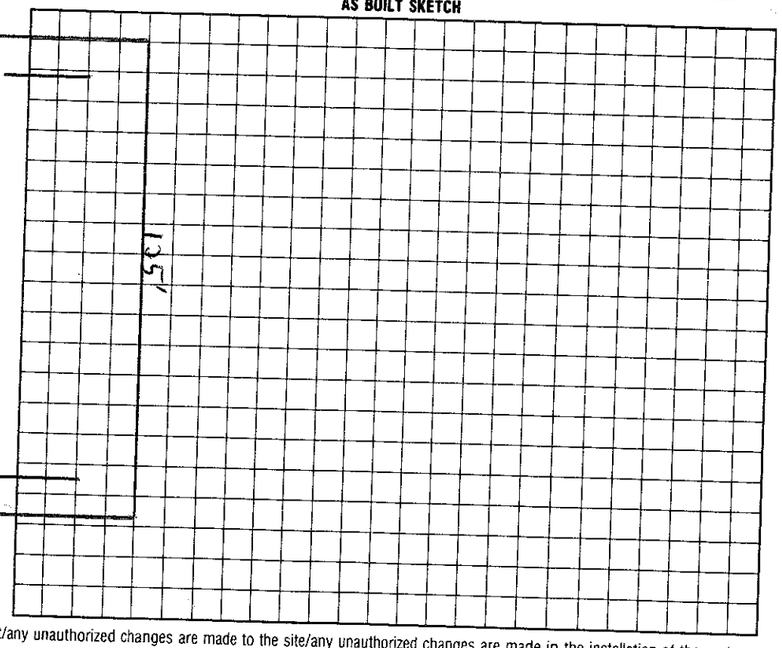

I understand that this permit can be suspended or revoked if any false information is supplied toward securing the permit/any unauthorized changes are made to the site/any unauthorized changes are made in the installation of the system.

Signed: Billy A. Miller Sr.

Improvement Permit by: C. Ray Steen EHSS date 6/6/96

~~Existing System Inspection~~ by: C. Ray Steen EHSS date 6/6/96

Installed by: Orlison Const.

Certificate of Completion by: date

Operation Permit by: Wesley Sparks R.S. date 7/11/96

HEALTH DEPT. COPY: WHITE INSPECTION COPY (FINAL): GREEN OWNER COPY (FINAL): YELLOW INSPECTION COPY (INITIAL): PINK OWNER COPY (INITIAL): GOLD

Authorization to Construct is Valid for 60 months from issue date.