IREDELL COUNTY HEALTH DEPARTMENT

STATESVILLE 704-878-5305 MOORESVILLE 704-664-5281

IMPROVEMENT PERMIT / AUTHORIZATION TO CONSTRUCT / OPERATION PERMIT / EXISTING SYSTEM INSPECTION

PERMIT# 074939 PIN# 4649 77 1179 DATE 8/4/98

OWNER OR CONTRACTOR Piedmont Housing - Wm Heefner PHONE: Business 528-7120 Home

ADDRESS 1040 Charlotte Hwy. Troutman, NC 28166

LOCATION Rankin Hill Rd., 115-21 N TL Flower House loop, TL Rankin Hill Rd., to 8th lot on (L)

SUBDIVISION Westwinds BLOCK / SECTION 1 LOT 19 LOT AREA .51 SITE CLASS. PS DESIGN FLOW 360 L.T.A.R. .3

Septic Tank: 1000 Gallons; STB 1012 Date 6/3/98
Pump Tank: Gallons; PT Date
Pump Make: Model Serial No.
Nitrification Field: No Fields 1 Square Feet 900* Linear Feet 300*
No Lines 4 Trench Width 36" Max Trench Bottom Depth 30" Gravel Depth SAND.

[X] New System [ ] Repair System Type: I, II, III, IV, V, VI
System Description: * Gravity Ch Plastic
Repair System Description: 16" PP BS - Gravity
Maintenance Agreement Required: [ ] Yes [X] No


[X] House/Mod. Home No. Bedrooms 3
[ ] Mobile Home No. Bathrooms 2
[ ] Business No. Employees
[ ] Other
[ ] Slab [X] Crawl Space [ ] Basement w/plumbing [ ] Basement wo/plumbing

Water Supply: [X] Individual [ ] Public [ ] Community


Comments:/Conditions: * 25% reduction for Ch. Plastic Material

Comments:/Conditions:

INITIAL SITE SKETCH

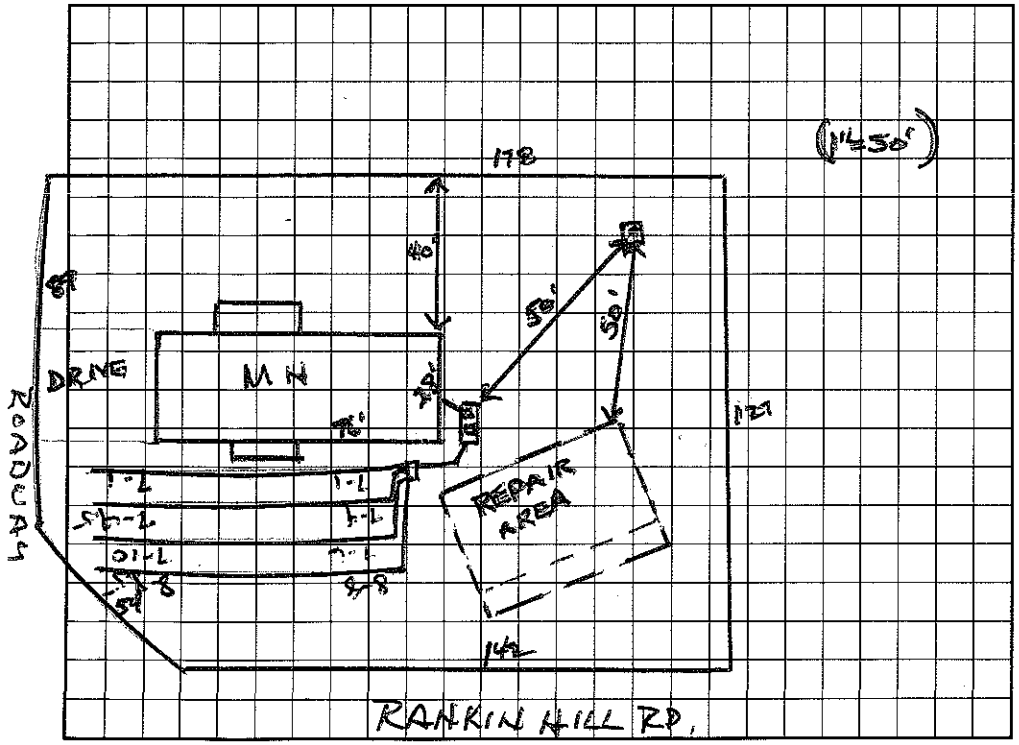

AS BUILT SKETCH

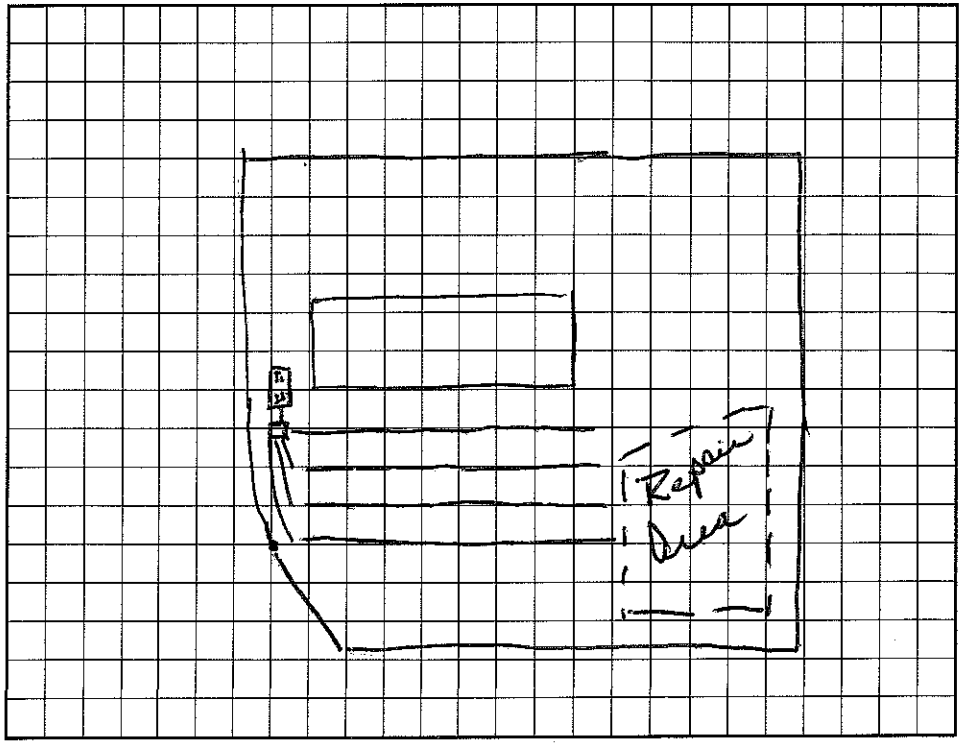

I understand that this permit can be suspended or revoked if any false information is supplied toward securing the permit/any unauthorized changes are made to the site/any unauthorized changes are made in the installation of the system. Improvement Permit with plat valid without expiration. Improvement Permit with site plan valid for sixty months. Authorization to Construct is valid for a period equal to that of Improvement Permit – not to exceed sixty months.

Signed: * date

Improvement Permit by: Wesley Sparks RS. date 8/4/98

Authorization to Construct by: Wesley Sparks RS. date 8/4/98

Installed by: A-1 Backhoe

Operation Permit by: Wesley Sparks RS date 8/5/98

Existing System Inspection by: Wesley Sparks RS date 8/5/98

HEALTH DEPT. COPY: WHITE INSPECTION COPY (FINAL): GREEN OWNER COPY (FINAL): YELLOW INSPECTION COPY (INITIAL): PINK OWNER COPY (INITIAL): GOLD