IREDELL COUNTY HEALTH DEPARTMENT

STATESVILLE 704-878-5305 MOORESVILLE 704-664-5281

IMPROVEMENT PERMIT / AUTHORIZATION TO CONSTRUCT / OPERATION PERMIT / EXISTING SYSTEM INSPECTION

PERMIT# 80826 PIN# ~~4649667891 PT~~ 4649772290 DATE 2/16/00

OWNER OR CONTRACTOR PIEDMONT HOUSING PHONE: Business _____ Home 528-7120

ADDRESS 1040 CHARLOTTE HWY - TROUTMAN

LOCATION RANKEN HILL - TL ELISABETH ANN - ON CT

SUBDIVISION WESTWINDS BLOCK / SECTION 3 LOT 55 LOT AREA .5AC SITE CLASS. PS DESIGN FLOW 360 GPD L.T.A.R. .3 gpd/ft²

Septic Tank: 1000 Gallons; STB 1012 Date 10/29/99

Pump Tank: _____ Gallons; PT _____ Date _____

Pump Make: _____ Model _____ Serial No. _____

Nitrification Field: No Fields 1 Square Feet 900 Linear Feet 300

No Lines 3@100' Trench Width 36" Max Trench Bottom Depth 36" Gravel Depth N/A

☑ New System ☐ Repair System Type: I, II, (III) IV, V, VI

System Description: CLASS 25% REDUCTION

Repair System Description: SAME

Maintenance Agreement Required: ☐ Yes ☑ No

☑ House/Mod. Home No. Bedrooms 3

☐ Mobile Home No. Bathrooms 3

☐ Business No. Employees ____

☐ Other _____


☐ Slab ☑ Crawl Space ☐ Basement w/plumbing ☐ Basement wo/plumbing

Water Supply: ☑ Individual ☐ Public ☐ Community

Comments:/Conditions:

Comments:/Conditions:

INITIAL SITE SKETCH 1" = 40'

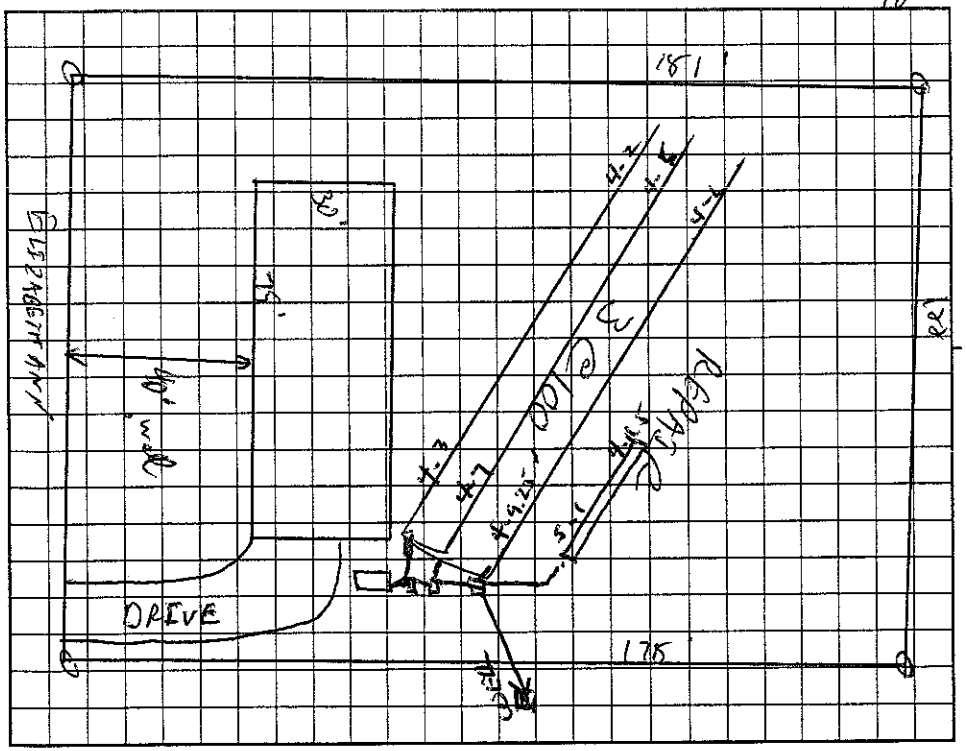

AS BUILT SKETCH

Permit can be suspended or revoked if any false information is supplied toward securing the permit/any unauthorized changes are made to the site/any unauthorized changes are made in the installation of the system. Improvement Permit with plat valid without expiration. Improvement Permit with site plan valid for sixty months. Authorization to Construct is valid for a period equal to that of Improvement Permit – not to exceed sixty months.

Signed: _____ date _____

Improvement Permit by: C. Dyer ES date 2/16/00

Authorization to Construct by: C. Dyer ES date 2/16/00

Installed by: A-1 Backhoe

Operation Permit by: Wesley Sparks e.s. date 2/16/00

Existing System Inspection by: _____ date _____

HEALTH DEPT. COPY: WHITE OWNER COPY (FINAL): YELLOW OWNER COPY (INITIAL): PINK