IREDELL COUNTY HEALTH DEPARTMENT

STATESVILLE 704-878-5305 MOORESVILLE 704-664-5281

IMPROVEMENT PERMIT / AUTHORIZATION TO CONSTRUCT / OPERATION PERMIT / EXISTING SYSTEM INSPECTION

PERMIT# 069132 PIN# 4649 66 7891 Pt. 4649 77 2401 DATE 6/17/98

OWNER OR CONTRACTOR Wm L. Hardner PHONE: Business 528-7120 Home

ADDRESS PO Box 1732 Lincolnton, NC. 28093

LOCATION Rankinhill Rd. on (L), 6th lot beyond #26, before Thoroughbred Lane

SUBDIVISION Westwinds BLOCK / SECTION 1 LOT 20 LOT AREA .59 Ac. SITE CLASS. 0 PS DESIGN FLOW 360 L.T.A.R. .3

Septic Tank: 1000 Gallons; STB 1012 Date 5-2-98
Pump Tank: 1000 Gallons; PT 1 Date
Pump Make: Hydromatic Model SK50A1 Serial No. 498
Nitrification Field: No Fields 1 Square Feet 900* Linear Feet 300*
No Lines 4 Trench Width 36" Max Trench Bottom Depth 36"

[X] New System [ ] Repair System Type: I, II, III, IV, V, VI
System Description: PreMan - Ch Plastic
Repair System Description: None
Maintenance Agreement Required: [ ] Yes [X] No

[X] House/Mod. Home No. Bedrooms 3
[ ] Mobile Home No. Bathrooms 2
[ ] Business No. Employees
[ ] Other


Gravel Depth STAND. [ ] Slab [X] Crawl Space [ ] Basement w/plumbing [ ] Basement wo/plumbing

Water Supply: [X] Individual [ ] Public [ ] Community

Comments:/Conditions: * 25% Reduction for Type III Chamber Kit

Comments:/Conditions:

INITIAL SITE SKETCH

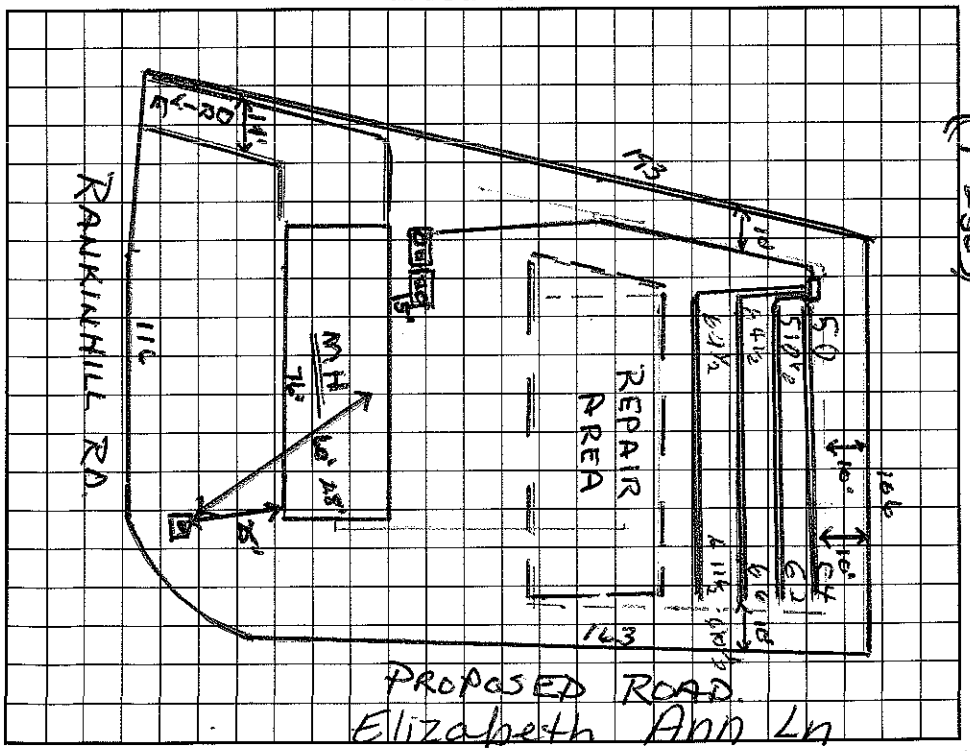

AS BUILT SKETCH

I understand that this permit can be suspended or revoked if any false information is supplied toward securing the permit/any unauthorized changes are made to the site/any unauthorized changes are made in the installation of the system. Improvement Permit with plat valid without expiration. Improvement Permit with site plan valid for sixty months. Authorization to Construct is valid for a period equal to that of Improvement Permit – not to exceed sixty months.

Signed: [signature] date 6/17/98 Installed by: A-1 Backhoe

Improvement Permit by: Wesley Sparks RS. date 6/17/98 Operation Permit by: Wesley Sparks RS. date 7/16/98

Authorization to Construct by: Wesley Sparks RS. date 6/17/98 Existing System Inspection by: Wesley Sparks RS date 7/16/98

HEALTH DEPT. COPY: WHITE INSPECTION COPY (FINAL): GREEN OWNER COPY (FINAL): YELLOW INSPECTION COPY (INITIAL): PINK OWNER COPY (INITIAL): GOLD