IREDELL COUNTY HEALTH DEPARTMENT

STATESVILLE 704-878-5305 MOORESVILLE 704-664-5281

IMPROVEMENT PERMIT / AUTHORIZATION TO CONSTRUCT / OPERATION PERMIT / EXISTING SYSTEM INSPECTION

PERMIT# 075822 PIN# 4649 66 7891 Prof. 4649 77 2515 DATE 8/11/98

OWNER OR CONTRACTOR Piedmont Housing #9 PHONE: Business 489-1128 Home

ADDRESS 4879 Hwy 16 N Denver, NC. 28037

LOCATION 115-21N TL Flowers House Loop TL Rankin Hill Rd. to 6th lot on (L)

SUBDIVISION Westwinds BLOCK / SECTION 1 LOT 21 LOT AREA .51 AC SITE CLASS. PS DESIGN FLOW 360 L.T.A.R. .3

Septic Tank: 1000 Gallons; STB Date 7/12/98
Pump Tank: 1000 Gallons; PT Date
Pump Make: Model Serial No.
Nitrification Field: No Fields 1 Square Feet ~~900~~ Linear Feet ~~300~~
No Lines 4 Trench Width 36" Max Trench Bottom Depth 36" Gravel Depth SAND

[X] New System [ ] Repair System Type: I, II, III, IV, V, VI
System Description: Presson – Ch Plastic
Repair System Description: Pres – PPBS
Maintenance Agreement Required: [ ] Yes [X] No

[ ] House/Mod. Home No. Bedrooms 3
[ ] Mobile Home No. Bathrooms 2
[ ] Business No. Employees
[ ] Other


[ ] Slab [X] Crawl Space [ ] Basement w/plumbing [ ] Basement wo/plumbing

Water Supply: [X] Individual [ ] Public [ ] Community


Comments/Conditions: ~~*~~ 25% Reduction for Ch Plastic used. HAS use.

Comments/Conditions: CHANGED TO GRAVITY CHAMBERS OR MOS. CBF. REORIENT AT SITE

INITIAL SITE SKETCH

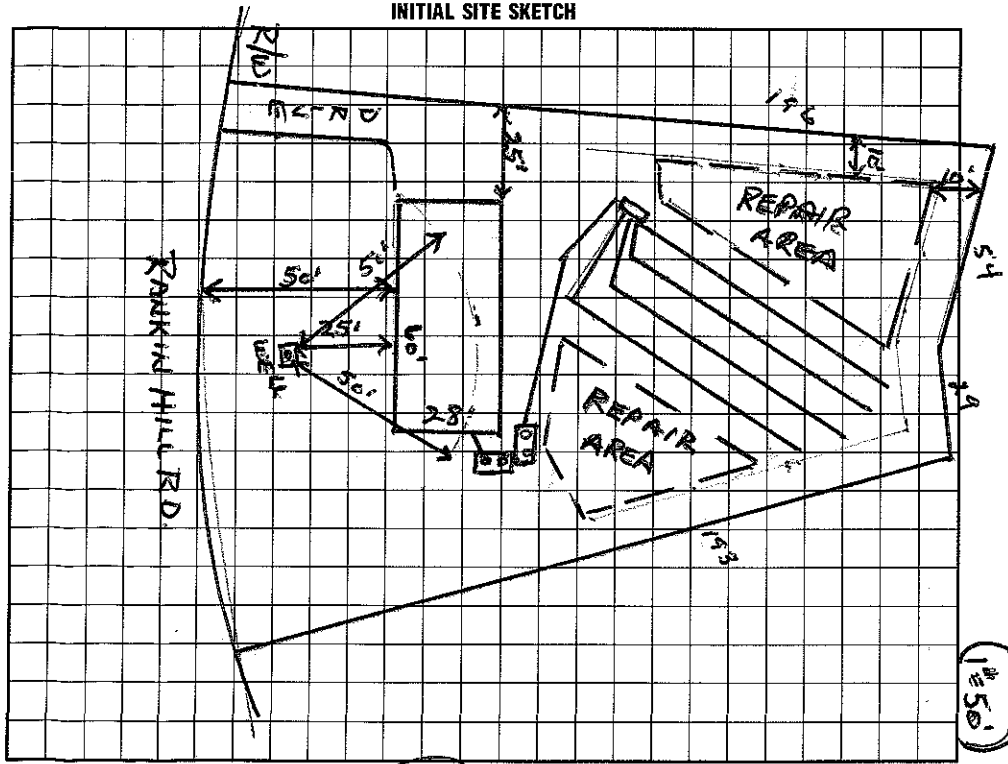

AS BUILT SKETCH

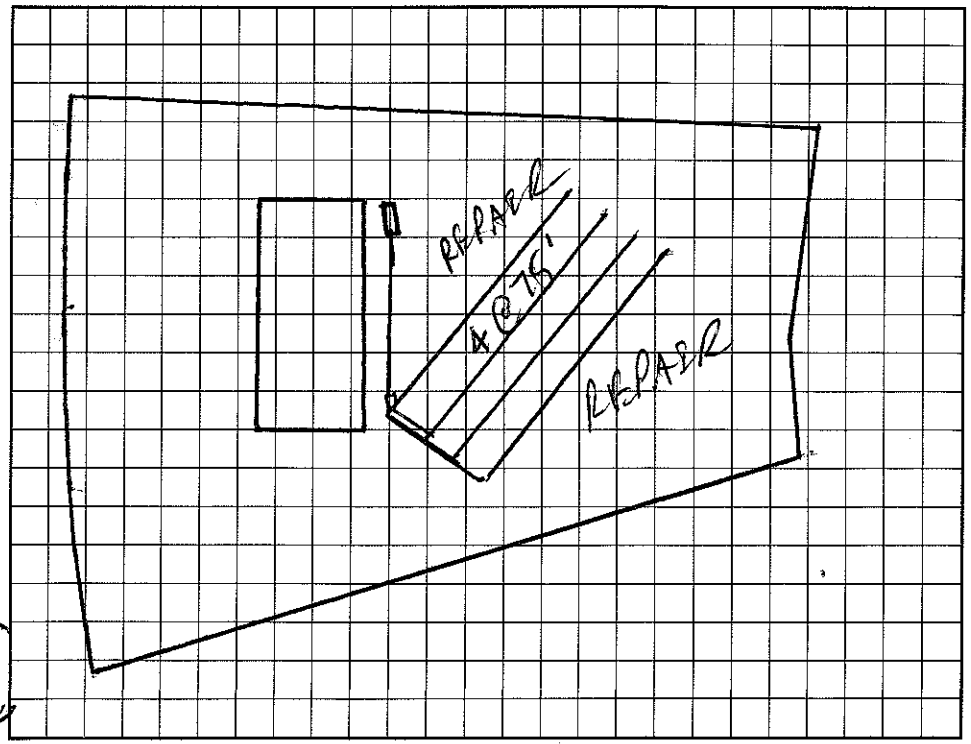

I understand that this permit can be suspended or revoked if any false information is supplied toward securing the permit/any unauthorized changes are made to the site/any unauthorized changes are made in the installation of the system. Improvement Permit with plat valid without expiration. Improvement Permit with site plan valid for sixty months. Authorization to Construct is valid for a period equal to that of Improvement Permit – not to exceed sixty months.

Signed: ~~*~~ date

Improvement Permit by: Wesley Sparks R.S. date 8/11/98

Authorization to Construct by: Wesley Sparks R.S. date 8/11/98

Installed by: A1 BACKHOE

Operation Permit by: C. [illegible] B date 9/17/98

Existing System Inspection by: date

HEALTH DEPT. COPY: WHITE INSPECTION COPY (FINAL): GREEN OWNER COPY (FINAL): YELLOW INSPECTION COPY (INITIAL): PINK OWNER COPY (INITIAL): GOLD