IREDELL COUNTY HEALTH DEPARTMENT

STATESVILLE 704-878-5305 MOORESVILLE 704-664-5281

IMPROVEMENT PERMIT / AUTHORIZATION TO CONSTRUCT / OPERATION PERMIT / EXISTING SYSTEM INSPECTION

PERMIT# 075824 PIN# 4649 66 7891 Apf 4649 77 2674 DATE 8/11/98

OWNER OR CONTRACTOR Piedmont Housing #9 PHONE: Business 489-1128 Home

ADDRESS 4879 N Hwy 16 Denver, NC. 28037

LOCATION Rankin Hill Rd. & 115-21N TL Flowers House Loop TL Rankin Hill Rd., 5th lot on (L)

SUBDIVISION Westwind BLOCK / SECTION 1 LOT 22 LOT AREA .58 AC SITE CLASS. PS DESIGN FLOW 480 L.T.A.R. .3

Septic Tank: 1000 Gallons; STB 1012 Date

Pump Tank: 1000 Gallons; PT Date

Pump Make: Model Serial No. 300

Nitrification Field: No Fields 1 Square Feet 1200* Linear Feet 400*

No Lines 5 Trench Width 36" Max Trench Bottom Depth 36" Gravel Depth SAND

[X] New System [ ] Repair System Type: I, II, [III], IV, V, VI

System Description: PresMan — CH. PLASTIC

Repair System Description: 16" PPBS - Pressure

Maintenance Agreement Required: [ ] Yes [X] No

[X] House/Mod. Home No. Bedrooms 4

[ ] Mobile Home No. Bathrooms 3

[ ] Business No. Employees

[ ] Other

[ ] Slab [X] Crawl Space [ ] Basement w/plumbing [ ] Basement wo/plumbing


Water Supply: [X] Individual [ ] Public [ ] Community

Comments:/Conditions: * 25% Reduction for Cham. Plastic on HDS use.


Comments:/Conditions: 75 - 75

7 - 71 - 7 - 71

INITIAL SITE SKETCH

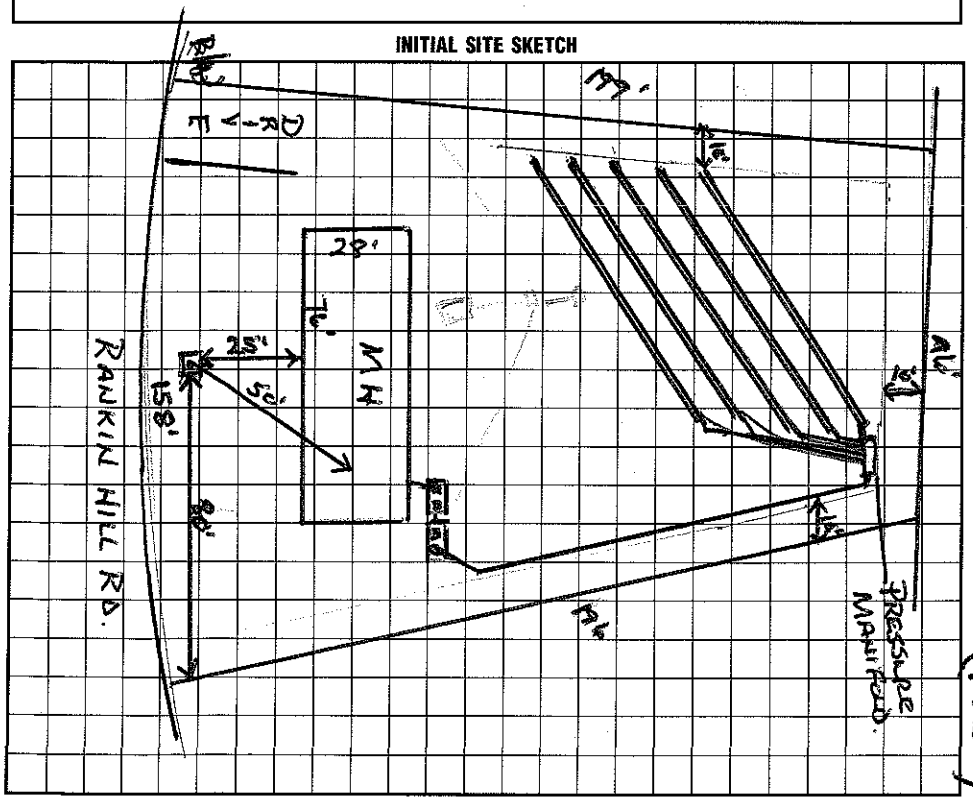

AS BUILT SKETCH

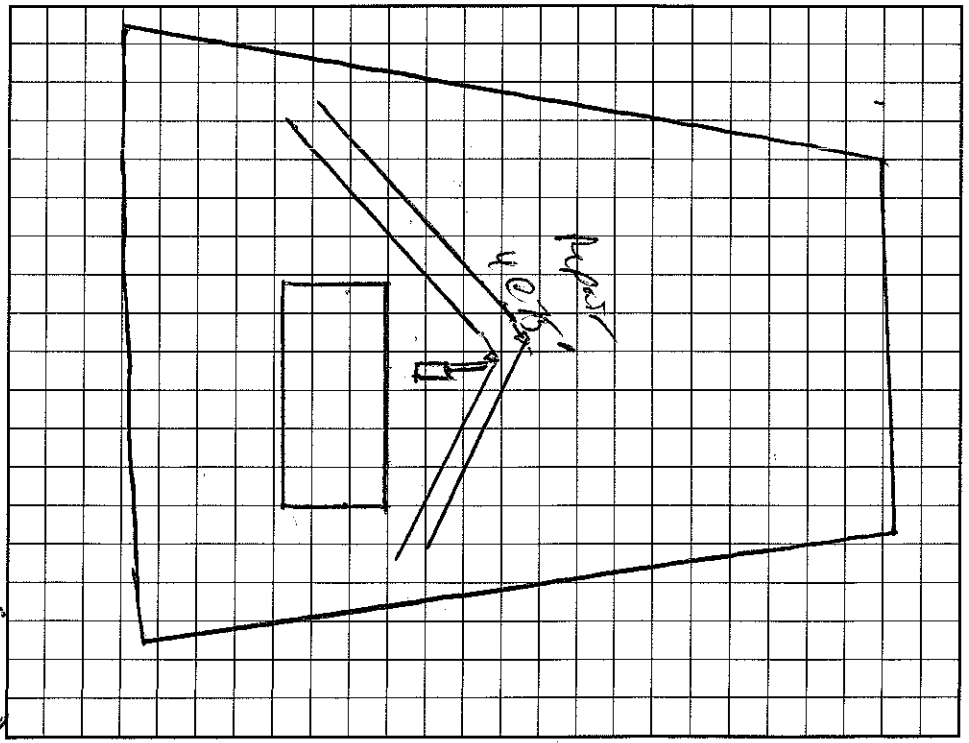

I understand that this permit can be suspended or revoked if any false information is supplied toward securing the permit/any unauthorized changes are made to the site/any unauthorized changes are made in the installation of the system. Improvement Permit with plat valid without expiration. Improvement Permit with site plan valid for sixty months. Authorization to Construct is valid for a period equal to that of Improvement Permit – not to exceed sixty months.

Signed: * Dennis Ballew date 9/28/98 Installed by: A-1 BACKHOE

Improvement Permit by: Wesley Sparks RS. date 8/11/98 Operation Permit by: C. [illegible] date 9/29/98

Authorization to Construct by: Wesley Sparks RS. date 8/11/98 Existing System Inspection by: date

HEALTH DEPT. COPY: WHITE INSPECTION COPY (FINAL): GREEN OWNER COPY (FINAL): YELLOW INSPECTION COPY (INITIAL): PINK OWNER COPY (INITIAL): GOLD