IREDELL COUNTY HEALTH DEPARTMENT

STATESVILLE 704-878-5305 MOORESVILLE 704-664-5281

IMPROVEMENT PERMIT / AUTHORIZATION TO CONSTRUCT / OPERATION PERMIT / EXISTING SYSTEM INSPECTION

PERMIT# 81585 PIN# ~~4649667891 PT~~ 4649773086 DATE 9/13/99

OWNER OR CONTRACTOR PIEDMONT HOUSING PHONE: Business 528 7120 Home

ADDRESS 1040 CHARLOTTE HWY TROUTMAN

LOCATION FLOWER HOUSE - TL RANKIN HILL. TL ELIZABETH ANNE. TR CRAVER LN AT END

SUBDIVISION WESTWINDS BLOCK / SECTION LOT 57 LOT AREA .59AC SITE CLASS. PS DESIGN FLOW 360 L.T.A.R. .3

Septic Tank: 1000 Gallons; STB 1012 Date 9/4/99
Pump Tank: Gallons; PT Date
Pump Make: Model Serial No.
Nitrification Field: No Fields 1 Square Feet 900 Linear Feet 300
No Lines 3@100' Trench Width 36" Max Trench Bottom Depth 36" Gravel Depth N/A

☑ New System ☐ Repair System Type: I II III IV, V, VI
System Description: GRAVITY 25% REDUCTION
Repair System Description: STATE
Maintenance Agreement Required: ☐ Yes ☑ No


☐ House/Mod. Home No. Bedrooms 3
☑ Mobile Home No. Bathrooms 2
☐ Business No. Employees
☐ Other
☐ Slab ☑ Crawl Space ☐ Basement w/plumbing ☐ Basement wo/plumbing

Water Supply: ☑ Individual ☐ Public ☐ Community


Comments:/Conditions:

Comments:/Conditions: Well Not installed at time of inspection.

INITIAL SITE SKETCH 1"=50'

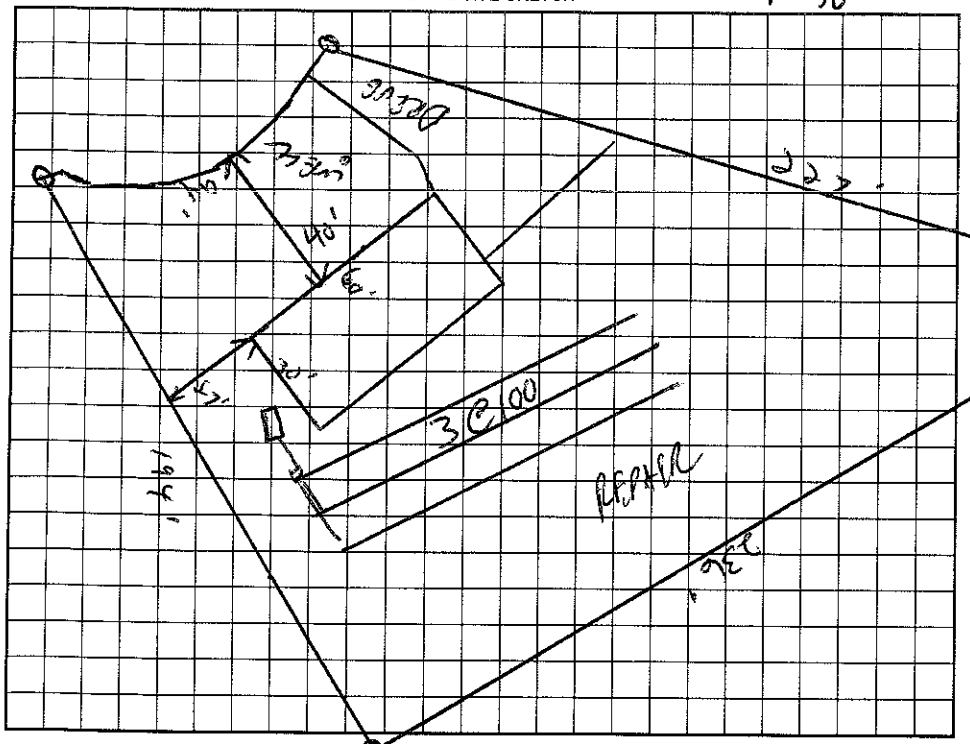

AS BUILT SKETCH

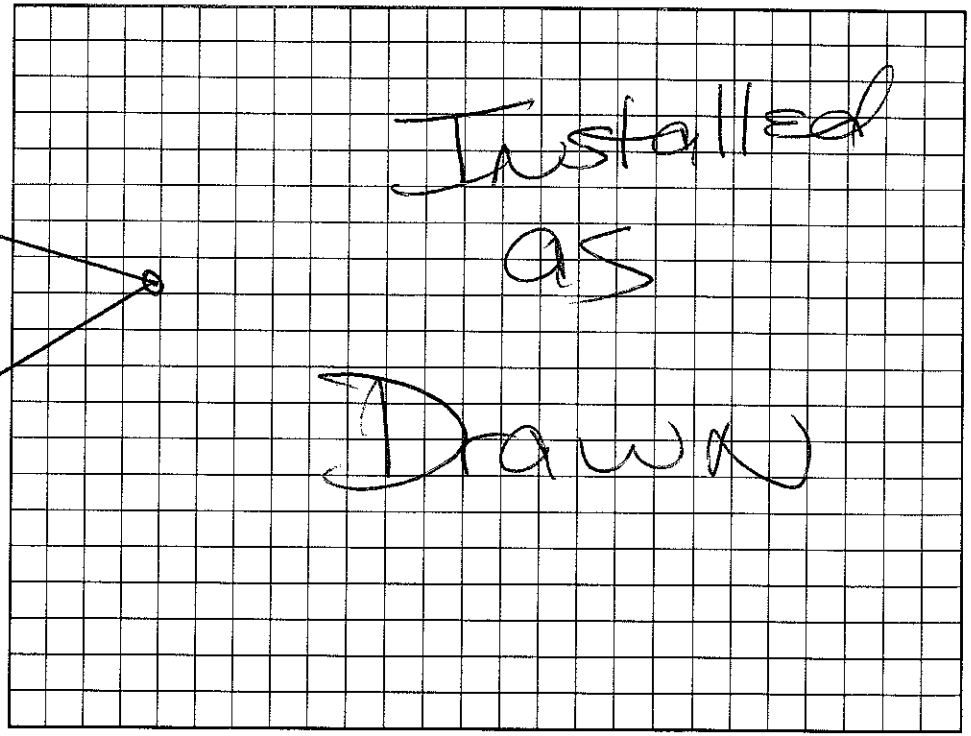

Permit can be suspended or revoked if any false information is supplied toward securing the permit/any unauthorized changes are made to the site/any unauthorized changes are made in the installation of the system. Improvement Permit with plat valid without expiration/ Improvement Permit with site plan valid for sixty months. Authorization to Construct is valid for a period equal to that of Improvement Permit – not to exceed sixty months.

Signed: David Hughes date 12/2/99

Improvement Permit by: C. Kelly Tolson KS date 9/13/99

Authorization to Construct by: C. Kelly Tolson KS date 9/13/99

Installed by: A-1 Backhoe

Operation Permit by: Maria H. Atkinson RS date 12/3/99

Existing System Inspection by: date

HEALTH DEPT. COPY: WHITE OWNER COPY (FINAL): YELLOW OWNER COPY (INITIAL): PINK