IREDELL COUNTY HEALTH DEPARTMENT

STATESVILLE 704-878-5305 MOORESVILLE 704-664-5281

IMPROVEMENT PERMIT / AUTHORIZATION TO CONSTRUCT / OPERATION PERMIT / EXISTING SYSTEM INSPECTION

PERMIT# 81882 PIN# 4649667850 91 - PT 4649773493 DATE 7/14/99

OWNER OR CONTRACTOR PIEDMONT HOUSING PHONE: Business 528-7120 Home

ADDRESS 1040 CHARLOTTE HWY TROUTMAN NC 28166

LOCATION RANKEN HILL - TL ELIZABETH ANN

SUBDIVISION WESTWINDS BLOCK / SECTION 3 LOT 65 LOT AREA .51 AC SITE CLASS. PS DESIGN FLOW 360 L.T.A.R. .36RD/FT

Septic Tank: 1000 Gallons; STB 1012 Date 7/15/99

Pump Tank: Gallons; PT Date

Pump Make: Model Serial No.

Nitrification Field: No Fields 1 Square Feet 900 Linear Feet 300

No Lines 4@75' Trench Width 36" Max Trench Bottom Depth 36" Gravel Depth N/A

☑ New System ☐ Repair System Type: I, II, (III), IV, V, VI

System Description: GRAVITY 25% REDUCTION

Repair System Description: SAME

Maintenance Agreement Required: ☐ Yes ☑ No

☐ House/Mod. Home ☐ Mobile Home ☐ Business ☐ Other

No. Bedrooms 3 No. Bathrooms 2 No. Employees


☐ Slab ☑ Crawl Space ☐ Basement w/plumbing ☐ Basement wo/plumbing

Water Supply: ☑ Individual ☐ Public ☐ Community

Comments:/Conditions:

Comments:/Conditions:

INITIAL SITE SKETCH

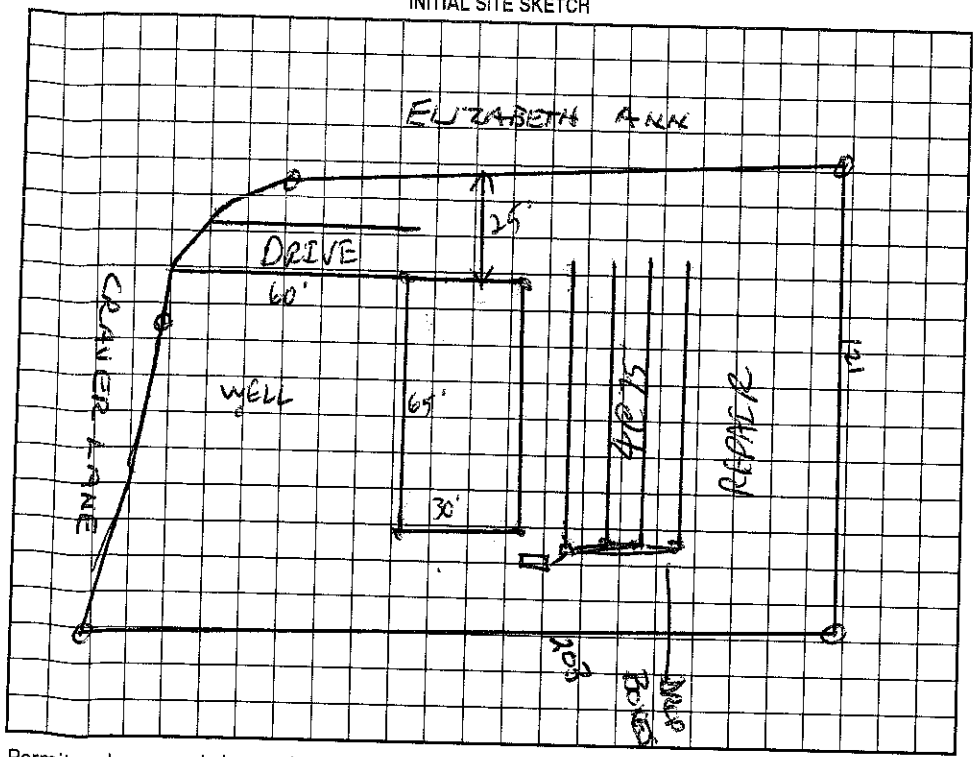

AS BUILT SKETCH

Permit can be suspended or revoked if any false information is supplied toward securing the permit/any unauthorized changes are made to the site/any unauthorized changes are made in the installation of the system. Improvement Permit with plat valid without expiration. Improvement Permit with site plan valid for sixty months. Authorization to Construct is valid for a period equal to that of Improvement Permit – not to exceed sixty months.

Signed: Renee M. Peters date 9-14-99 Installed by: A-1 Backhoe

Improvement Permit by: C. Ty Thompson, RS date 7/14/99 Operation Permit by: Wesley Sparks R.S. date 9/16/99

Authorization to Construct by: C. Ty Thompson, RS date 7/14/99 Existing System Inspection by: date

HEALTH DEPT. COPY: WHITE OWNER COPY (FINAL): YELLOW OWNER COPY (INITIAL): PINK