IREDELL COUNTY HEALTH DEPARTMENT

STATESVILLE 704-878-5305 MOORESVILLE 704-664-5281

IMPROVEMENT PERMIT / AUTHORIZATION TO CONSTRUCT / OPERATION PERMIT / EXISTING SYSTEM INSPECTION

PERMIT# 075826 PIN# 4649 66 7891 4649 77 4850 DATE 9/21/98

OWNER OR CONTRACTOR Piedmont Housing #9 PHONE: Business 489-1128 Home

ADDRESS 4879 N Hwy 16 Denver, NC. 28037

LOCATION Rankin Hill Rd off Flowerhouse Loop. to 3rd lot on (L)

SUBDIVISION Westwinds BLOCK / SECTION 1 LOT 24 LOT AREA .51 Ac SITE CLASS. PS DESIGN FLOW 360 L.T.A.R. .3

Septic Tank: 1000 Gallons; STB 826 Date 9/3/98
Pump Tank: 1000 Gallons; PT 40 Date 9/3/98
Pump Make: ZOELLER Model N53C Serial No. 11/30/98
Nitrification Field: No Fields 1 Square Feet 900 * Linear Feet 300*
No Lines 3 Trench Width 36" Max Trench Bottom Depth 36" Gravel Depth SAND.

[X] New System [ ] Repair System Type: I, II, (III), IV, V, VI
System Description: Pres. Man – Ch. Plastic
Repair System Description: Ch. Plastic
Maintenance Agreement Required: [ ] Yes [X] No

[X] House/Mod. Home No. Bedrooms 3
[ ] Mobile Home No. Bathrooms 3
[ ] Business No. Employees
[ ] Other

[ ] Slab [X] Crawl Space [ ] Basement w/plumbing [ ] Basement wo/plumbing


Water Supply: [X] Individual [ ] Public [ ] Community

Comments:/Conditions: Lot has complex topography – system shown in most well drained soil area on lot.

Comments:/Conditions: 3.5

1"=40'

INITIAL SITE SKETCH

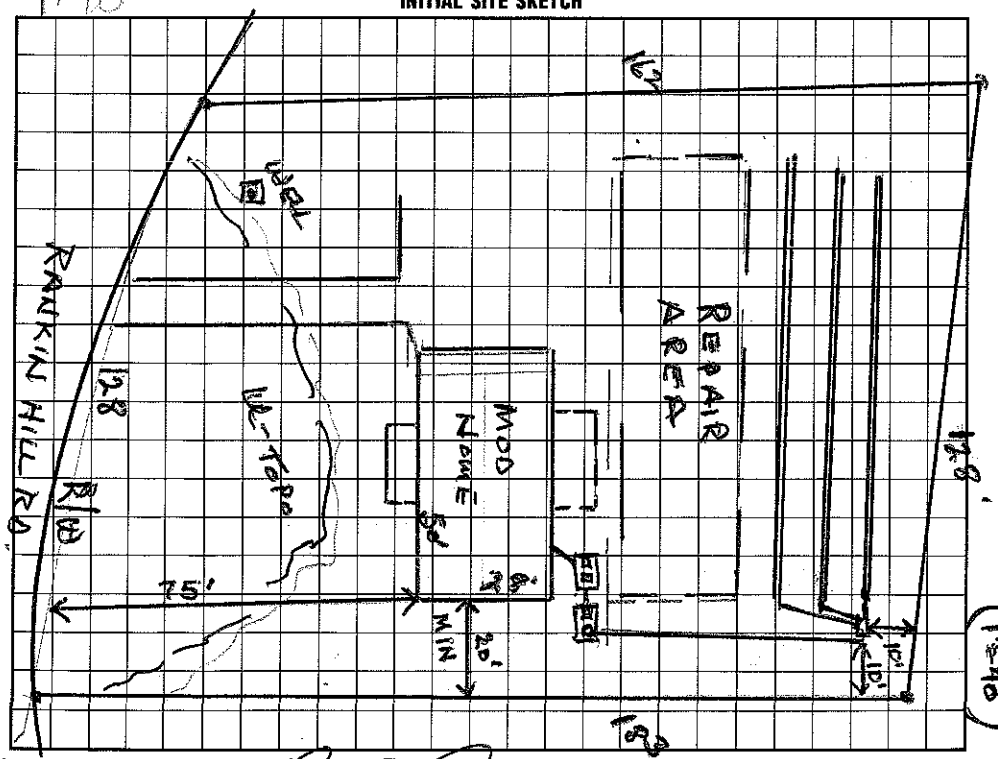

AS BUILT SKETCH

I understand that this permit can be suspended or revoked if any false information is supplied toward securing the permit/any unauthorized changes are made to the site/any unauthorized changes are made in the installation of the system. Improvement Permit with plat valid without expiration. Improvement Permit with site plan valid for sixty months. Authorization to Construct is valid for a period equal to that of Improvement Permit – not to exceed sixty months.

Signed: [signature] date 10-7-98 Installed by: B+M Enterprises

Improvement Permit by: Wesley Sparks R.S. date 9/21/98 Operation Permit by: Wesley Sparks date 1/19/99

Authorization to Construct by: Wesley Sparks R.S. date 9/21/98 Existing System Inspection by: date

HEALTH DEPT. COPY: WHITE INSPECTION COPY (FINAL): GREEN OWNER COPY (FINAL): YELLOW INSPECTION COPY (INITIAL): PINK OWNER COPY (INITIAL): GOLD