(3-30)

IREDELL COUNTY HEALTH DEPARTMENT

STATESVILLE 704-878-5305 MOORESVILLE 704-664-5281

IMPROVEMENT PERMIT / AUTHORIZATION TO CONSTRUCT / OPERATION PERMIT / EXISTING SYSTEM INSPECTION

PERMIT# 80828 PIN# ~~4649667891 AF~~ 4649775275 DATE 5/11/99

OWNER OR CONTRACTOR PIEDMONT HOUSE INC PHONE: Business 528-7120 Home

ADDRESS 1040 CHARLOTTE HWY · TROUTMAN NC 28166

LOCATION RANKEN HILL · TL ELIZABETH ANNE - TR CRAVER - ON LT

SUBDIVISION WESTWINDS BLOCK / SECTION 3 LOT 59 LOT AREA .54C SITE CLASS. PS DESIGN FLOW 360 L.T.A.R. .3

Septic Tank: 1000 Gallons; STB 1013 Date 4/30/99
Pump Tank: Gallons; PT Date
Pump Make: Model Serial No.
Nitrification Field: No Fields 1 Square Feet 900 Linear Feet 300
No Lines 3@100' Trench Width 36" Max Trench Bottom Depth 36" Gravel Depth N/A

☐ ~~New System~~ ☐ Repair System Type: I, II, III, IV, V, VI
System Description: GRAVITY EZLAY OR LHA - PGCS
Repair System Description: PANEL
Maintenance Agreement Required: ☐ Yes ☑ No


☐ House/Mod. Home No. Bedrooms 3
☐ Mobile Home No. Bathrooms 3
☐ Business No. Employees
☐ Other
☐ Slab ☑ Crawl Space ☐ Basement w/plumbing ☐ Basement wo/plumbing

Water Supply: ☑ ~~Individual~~ ☐ Public ☐ Community

Comments:/Conditions: HOUSE MAY BE ADJUSTED TO FOLLOW CONTOURS.

Comments:/Conditions:

INITIAL SITE SKETCH 1" = 50'

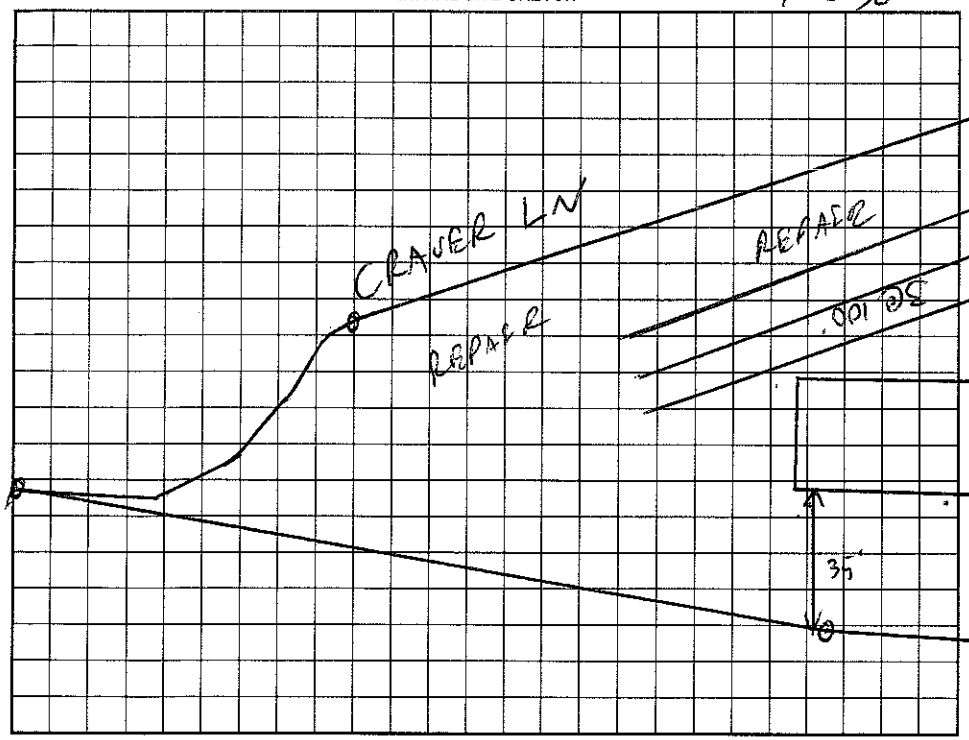

AS BUILT SKETCH

Permit can be suspended or revoked if any false information is supplied toward securing the permit/any unauthorized changes are made to the site/any unauthorized changes are made in the installation of the system. Improvement Permit with plat valid without expiration. Improvement Permit with site plan valid for sixty months. Authorization to Construct is valid for a period equal to that of Improvement Permit – not to exceed sixty months.

Signed: Teresa Newton date 5-11-99 Installed by: A1 BACKHOE

Improvement Permit by: C. [illegible] RS date 5/11/99 Operation Permit by: C. [illegible] PS date 6/18/99

Authorization to Construct by: C. [illegible] date 5/11/99 Existing System Inspection by: date

HEALTH DEPT. COPY: WHITE OWNER COPY (FINAL): YELLOW OWNER COPY (INITIAL): PINK