IREDELL COUNTY HEALTH DEPARTMENT

STATESVILLE 704-878-5305 MOORESVILLE 704-664-5281

IMPROVEMENT PERMIT / AUTHORIZATION TO CONSTRUCT / OPERATION PERMIT / EXISTING SYSTEM INSPECTION

10700

PERMIT# 075829 PIN# ~~4644 66 78 91~~ 4649775867 DATE 11/25/98

OWNER OR CONTRACTOR PIEDMONT HOUSING PHONE: Business 464-1128 Home

ADDRESS 4879 N. HWY 16 DENVER NC 28037

LOCATION RANKENHELL RD. - L ON FLOWER HOUSE UP ON L 2ND ON LT

SUBDIVISION WESTWOODS BLOCK / SECTION 1 LOT 25 LOT AREA .52AC SITE CLASS. IVS DESIGN FLOW 360 L.T.A.R. 3

Septic Tank: 1000 Gallons; STB 1012 Date 9-17-98
Pump Tank: Gallons; PT Date
Pump Make: Model Serial No.
Nitrification Field: No Fields 1 Square Feet 900 Linear Feet 300
No Lines 4@75' Trench Width 36" Max Trench Bottom Depth 36"

☑ New System ☐ Repair System Type: I, II, III, IV, V, VI
System Description: GRAVITY CHAMBERS OR IVS
Repair System Description: SAME
Maintenance Agreement Required: ☐ Yes ☑ No
Gravel Depth N/A


☑ House/Mod. Home No. Bedrooms 3
☐ Mobile Home No. Bathrooms 2
☐ Business No. Employees
☐ Other
☐ Slab ☑ Crawl Space ☐ Basement w/plumbing ☐ Basement wo/plumbing

Water Supply: ☑ Individual ☐ Public ☐ Community

Comments:/Conditions:

Comments:/Conditions:
MH Not on site at time of inspection
Well Not installed at time of inspection
MD

INITIAL SITE SKETCH

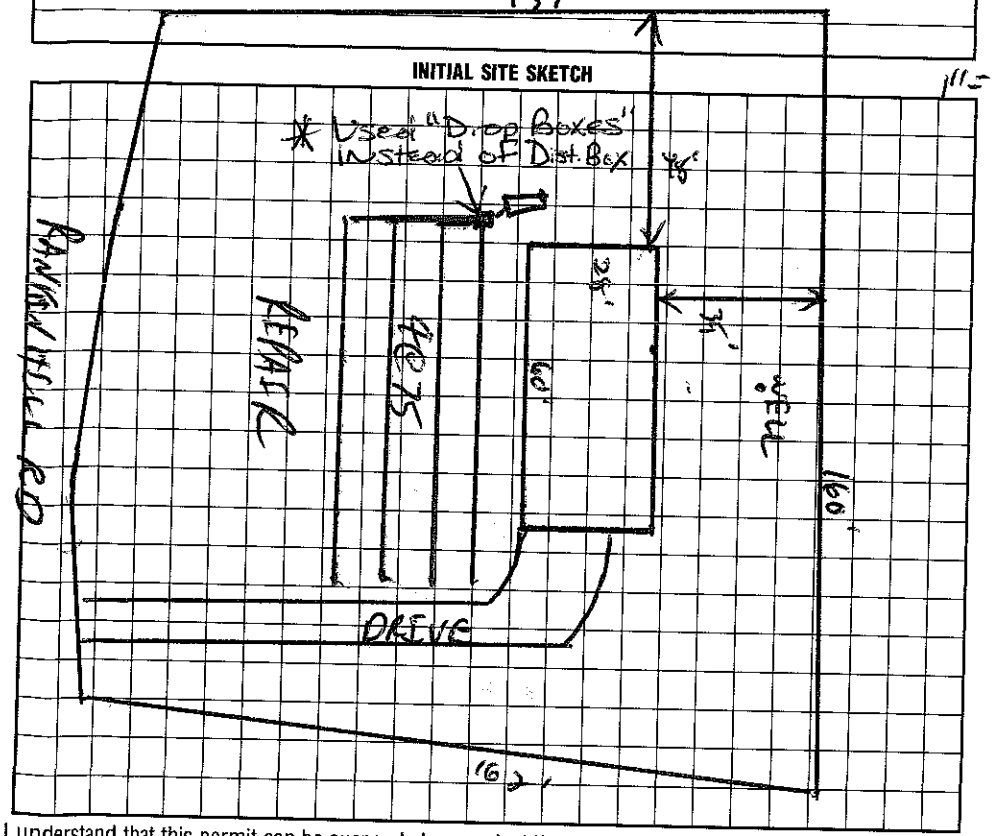

1" = 50'

AS BUILT SKETCH

I understand that this permit can be suspended or revoked if any false information is supplied toward securing the permit/any unauthorized changes are made to the site/any unauthorized changes are made in the installation of the system. Improvement Permit with plat valid without expiration. Improvement Permit with site plan valid for sixty months. Authorization to Construct is valid for a period equal to that of Improvement Permit – not to exceed sixty months.

Signed: date

Improvement Permit by: C. [signature] KS date 11/25/98

Authorization to Construct by: C. [signature] KS date 11/25/98

Installed by: A-1 Backhoe

Operation Permit by: [signature] Maria Dotson RS date 11/25/98

Existing System Inspection by: Maria Dotson date

HEALTH DEPT. COPY: WHITE INSPECTION COPY (FINAL): GREEN OWNER COPY (FINAL): YELLOW INSPECTION COPY (INITIAL): PINK OWNER COPY (INITIAL): GOLD