IREDELL COUNTY HEALTH DEPARTMENT

STATESVILLE 704-878-5305 MOORESVILLE 704-664-5281

IMPROVEMENT PERMIT / AUTHORIZATION TO CONSTRUCT / OPERATION PERMIT / EXISTING SYSTEM INSPECT

PERMIT# 80206 PIN# 4649667897 4649776790 DATE 4/9/99

OWNER OR CONTRACTOR PIEDMONT HOUSING PHONE: Business Home 528-7120

ADDRESS 1040 CHARLOTTE HWY TROUTMAN NC 28166

LOCATION 115N - TL FLOWER HOUSE - TL RANKEN HILL - TL ELIZABETHANN - TL CRAVER - AT END

SUBDIVISION WESTWINDS BLOCK / SECTION 3 LOT 62 LOT AREA .86 AC SITE CLASS. RS DESIGN FLOW 360 L.T.A.R. .30 AD/FT²

Septic Tank: 1000 Gallons; STB Date

Pump Tank: Gallons; PT Date

Pump Make: Model Serial No.

Nitrification Field: No Fields 1 Square Feet 900 Linear Feet 300

No Lines 3 @ 100' Trench Width 36" Max Trench Bottom Depth 18"

☑ New System ☐ Repair System Type: I, II, III, IV, V, VI

System Description: EZ LAY or Approved Culte

Repair System Description: SAME

Maintenance Agreement Required: ☐ Yes ☑ No

Gravel Depth N/A

☑ House/Mod. Home No. Bedrooms 3

☐ Mobile Home No. Bathrooms 2

☐ Business No. Employees

☐ Other


☐ Slab ☑ Crawl Space ☐ Basement w/plumbing ☐ Basement wo/plumbing

Water Supply: ☑ Individual ☐ Public ☐ Community


Comments:/Conditions:

Comments:/Conditions:

INITIAL SITE SKETCH

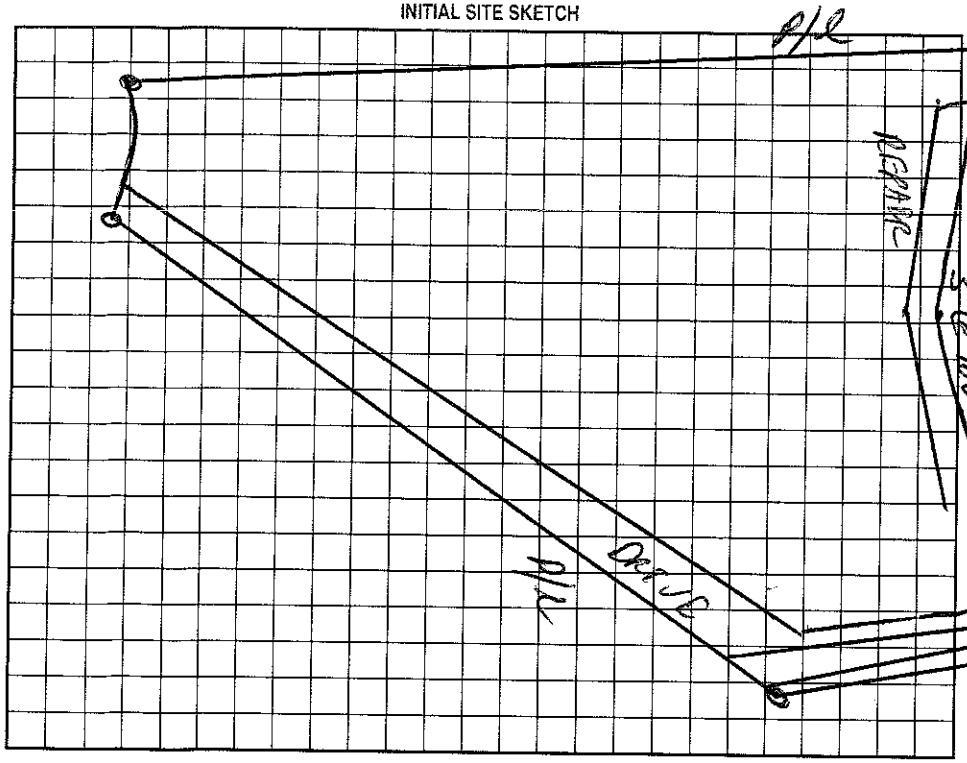

AS BUILT SKETCH

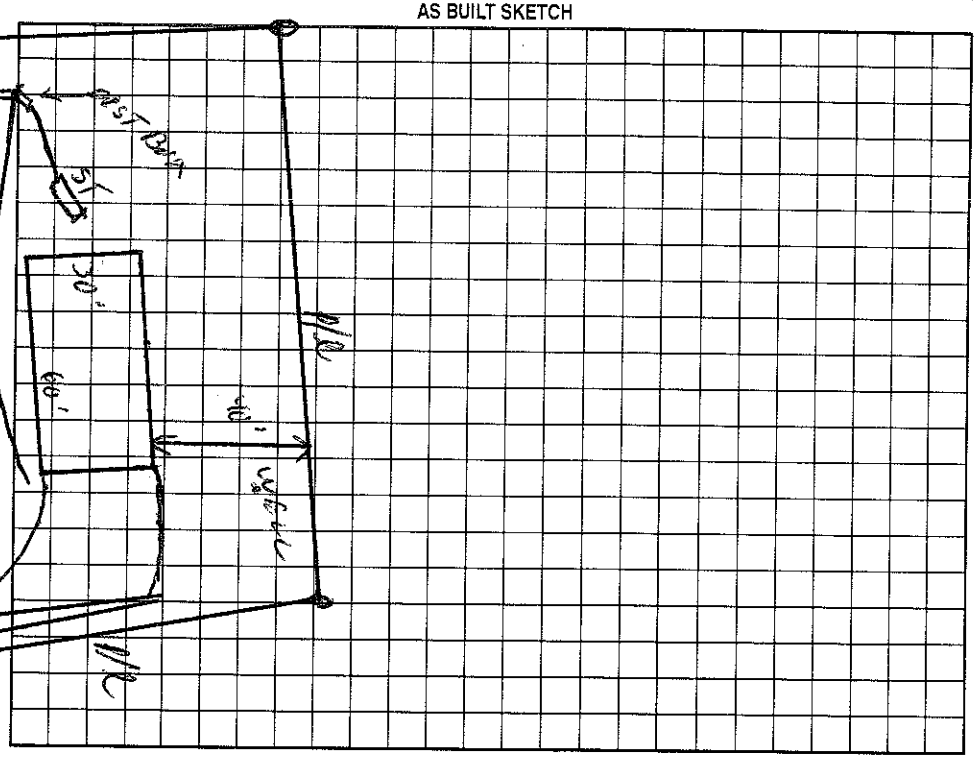

Permit can be suspended or revoked if any false information is supplied toward securing the permit/any unauthorized changes are made to the site/any unauthorized changes are made in the installation of the system. Improvement Permit with plat valid without expiration. Improvement Permit with site plan valid for sixty months. Authorization to Construct is valid for a period equal to that of Improvement Permit – not to exceed sixty months.

Signed: David Hyles date 4/9/99

Improvement Permit by: C. Hyles RS date 4/7/99

Authorization to Construct by: C. Hyles RS date 4/9/99

Installed by: A1 BACKHOE

Operation Permit by: C. Hyles date 4/9/99

Existing System Inspection by: date

HEALTH DEPT. COPY: WHITE OWNER COPY (FINAL): YELLOW OWNER COPY (INITIAL): PINK