IREDELL COUNTY HEALTH DEPARTMENT

STATESVILLE 704-878-5305 MOORESVILLE 704-664-5281

IMPROVEMENT PERMIT / AUTHORIZATION TO CONSTRUCT / OPERATION PERMIT / EXISTING SYSTEM INSPECTION

PERMIT# 074111 PIN# ~~4649 66 7891 (AT)~~ 4649777930 DATE 6/17/98

OWNER OR CONTRACTOR Wm L Heafner PHONE: Business 528-7120 Home

ADDRESS PO Box 1732 Lincolnton, NC. 28093

LOCATION Rankinhill Rd just S of on (L) before Thoroughbred Dr.

SUBDIVISION Westwinds BLOCK / SECTION 1 LOT 24 LOT AREA ~.7AC SITE CLASS. PS DESIGN FLOW 360 L.T.A.R. .3

Septic Tank: 1000 Gallons; STB 1612 Date 4/16/98
Pump Tank: Gallons; PT Date
Pump Make: Model Serial No.
Nitrification Field: No Fields 1 Square Feet 900# Linear Feet 300#
No Lines 4 Trench Width 36" Max Trench Bottom Depth 36" Gravel Depth SAND

[X] New System [ ] Repair System Type: I, II, III, IV, V, VI
System Description: Drop Box - Ctt. Plastic
Repair System Description: Same
Maintenance Agreement Required: [ ] Yes [X] No

[X] House/Mod. Home No. Bedrooms 3
[ ] Mobile Home No. Bathrooms 2
[ ] Business No. Employees
[ ] Other

[ ] Slab [X] Crawl Space [ ] Basement w/plumbing [ ] Basement wo/plumbing


Water Supply: [X] Individual [ ] Public [ ] Community

Comments:/Conditions: * 25% reduction for Type III chamber field

Tony DeWeese - 662-9028
463-4511

Comments:/Conditions:

INITIAL SITE SKETCH

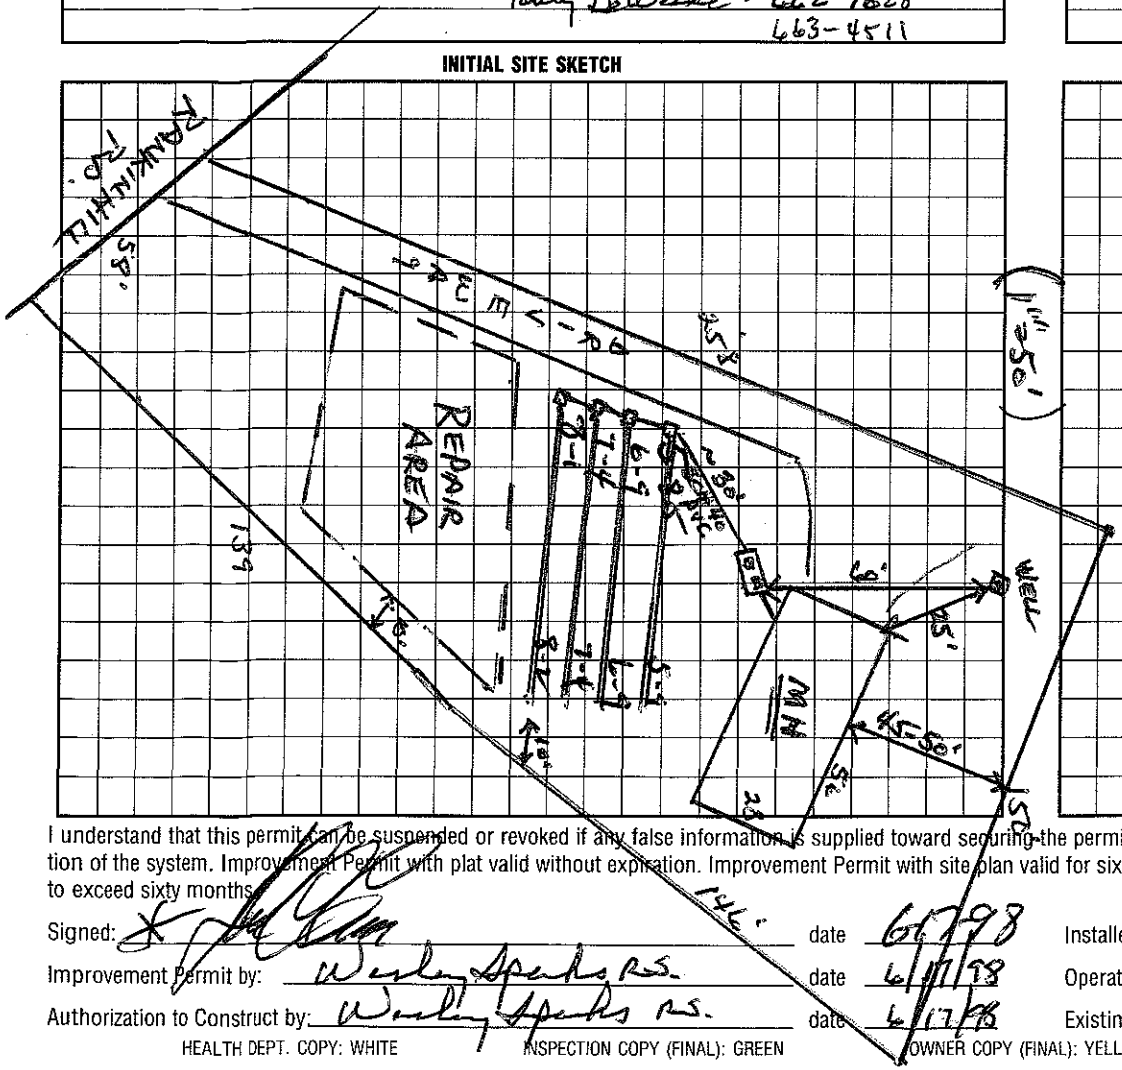

AS BUILT SKETCH

I understand that this permit can be suspended or revoked if any false information is supplied toward securing the permit/any unauthorized changes are made to the site/any unauthorized changes are made in the installation of the system. Improvement Permit with plat valid without expiration. Improvement Permit with site plan valid for sixty months. Authorization to Construct is valid for a period equal to that of Improvement Permit – not to exceed sixty months.

Signed: * date 6/17/98 Installed by: A-1 Backhoe

Improvement Permit by: Wesley Sparks R.S. date 6/17/98 Operation Permit by: Wesley Sparks R.S. date 6/22/98

Authorization to Construct by: Wesley Sparks R.S. date 6/17/98 Existing System Inspection by: date

HEALTH DEPT. COPY: WHITE INSPECTION COPY (FINAL): GREEN OWNER COPY (FINAL): YELLOW INSPECTION COPY (INITIAL): PINK OWNER COPY (INITIAL): GOLD