IREDELL COUNTY HEALTH DEPARTMENT

Authorization to Construct

STATESVILLE 704-878-5305 MOORESVILLE 704-664-5281

IMPROVEMENT PERMIT / ~~CERTIFICATE OF COMPLETION~~ / OPERATION PERMIT / EXISTING SYSTEM INSPECTION

PROPERTY DESCRIPTION NO. 26309 DATE 3/14/97 TAX MAP NO. 4649778220

OWNER OR CONTRACTOR Lynol Hannah. PHONE: Business _____ Home 528-3873 Watershed: ☒ Yes ☐ No

ADDRESS 153 Sorrell Ln. Troutman, NC. 28166

LOCATION Rankin Hall Rd to Palomino Park TL to 5th house on L

SUBDIVISION Palomino Park BLOCK / SECTION _____ LOT 58 LOT AREA >20000 FT² SITE CLASS. PS DESIGN FLOW 360 L.T.A.R. .3

Septic Tank: Existing Gallons; STB _____ Date _____

Pump Tank: _____ Gallons; PT _____ Date _____

Pump Make: _____ Model _____ Serial No. _____

Nitrification Field: No Fields 1 Square Feet 210 Linear Feet 70

No Lines 1 Trench Width 36" ~~Max Trench Bottom Depth~~ 31 Gravel Depth 12"

☐ New System ☒ Repair System Type: I, II, III, IV, V, VI

System Description: 2 DROP BOXES -

Repair System Description: _____

Maintenance Agreement Required: ☐ Yes ☒ No

☐ Slab ☒ Crawl Space ☐ Basement w/plumbing ☐ Basement wo/plumbing

☐ House/Mod. Home No. Bedrooms 3

☒ Mobile Home No. Bathrooms 3

☐ Business No. Employees _____

☐ Other _____


Water Supply:
☒ Individual
☐ Community
☐ Public

Comments:

DEED SITE

Comments:

INITIAL SITE SKETCH

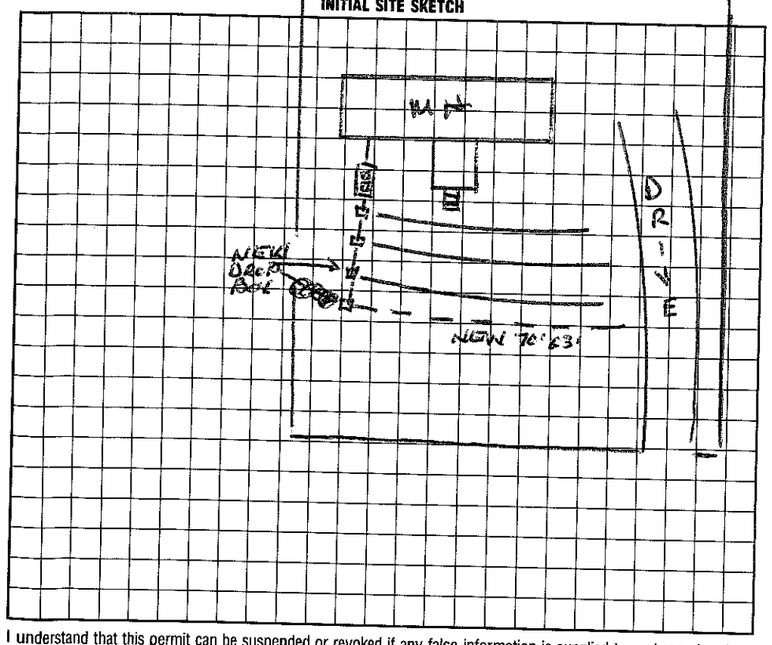

AS BUILT SKETCH

I understand that this permit can be suspended or revoked if any false information is supplied toward securing the permit/any unauthorized changes are made to the site/any unauthorized changes are made in the installation of the system. Improvement Permit is valid for 60 months from date of issuance.

Signed: Lynol L Hannah

Improvement Permit by: Wesley Sparks R.S. date 3/14/97

~~Existing System~~ Inspection by: Wesley Sparks R.S. date 3/14/97

Installed by: A1 BACKHOE

Certificate of Completion by: _____ date _____

Operation Permit by: C. [signature] date 1/14/98

HEALTH DEPT. COPY: WHITE INSPECTION COPY (FINAL): GREEN OWNER COPY (FINAL): YELLOW INSPECTION COPY (INITIAL): PINK OWNER COPY (INITIAL): GOLD