IREDELL COUNTY HEALTH DEPARTMENT

STATESVILLE 704-878-5305 MOORESVILLE 704-664-5281

IMPROVEMENT PERMIT / CERTIFICATE OF COMPLETION / OPERATION PERMIT / EXISTING SYSTEM INSPECTION

PROPERTY DESCRIPTION NO. 22167 DATE 9/18/95 TAX MAP NO. 4E 3A 53 Watershed: [X] Yes [ ] No

OWNER OR CONTRACTOR Lyman Homes Co. (MAYHORN) PHONE: Business 4649-77-8770 Home 535-0120

ADDRESS 7904 Saddlemore Ct. Char., NC. 28215

LOCATION

SUBDIVISION Palomino Park BLOCK / SECTION LOT 53 LOT AREA SITE CLASS. PS DESIGN FLOW 360 L.T.A.R. .3

Septic Tank: 1000 Gallons; STB 794 Date 9/13/95

Pump Tank: Gallons; PT Date

Pump Make: Model Serial No.

Nitrification Field: No Fields 1 Square Feet 1200 Linear Feet 400

No Lines 4 Trench Width 36" Max Trench Bottom Depth 36" Gravel Depth 12"

[X] New System [ ] Repair System Type: I, II, III, IV, V, VI

System Description: CONC - DIST BOX

Repair System Description: PREFAB PANEL

Maintenance Agreement Required: [ ] Yes [X] No

[ ] Slab [X] Crawl Space [ ] Basement w/plumbing [ ] Basement wo/plumbing

[X] House/Mod. Home No. Bedrooms 3

[ ] Mobile Home No. Bathrooms 2

[ ] Business No. Employees


[ ] Other

Water Supply: [X] Individual [ ] Community [ ] Public


Comments:

Comments:

INITIAL SITE SKETCH

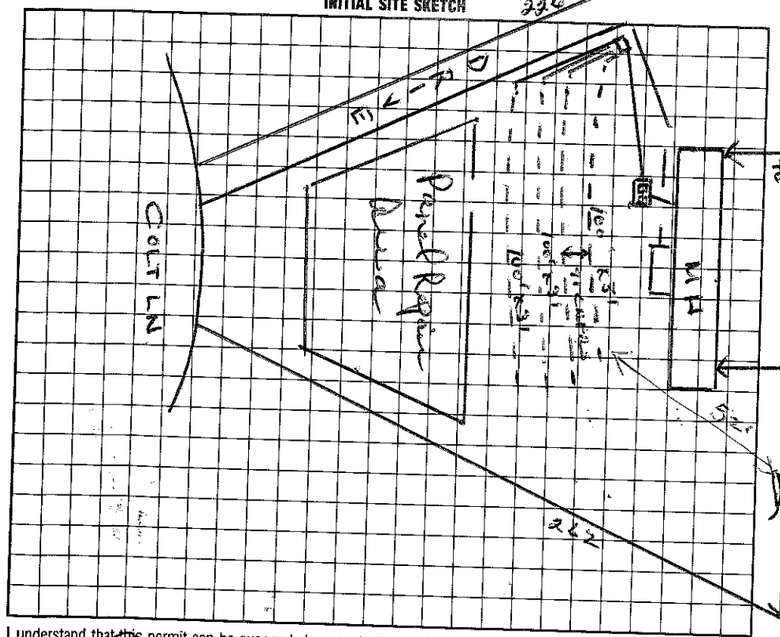

AS BUILT SKETCH

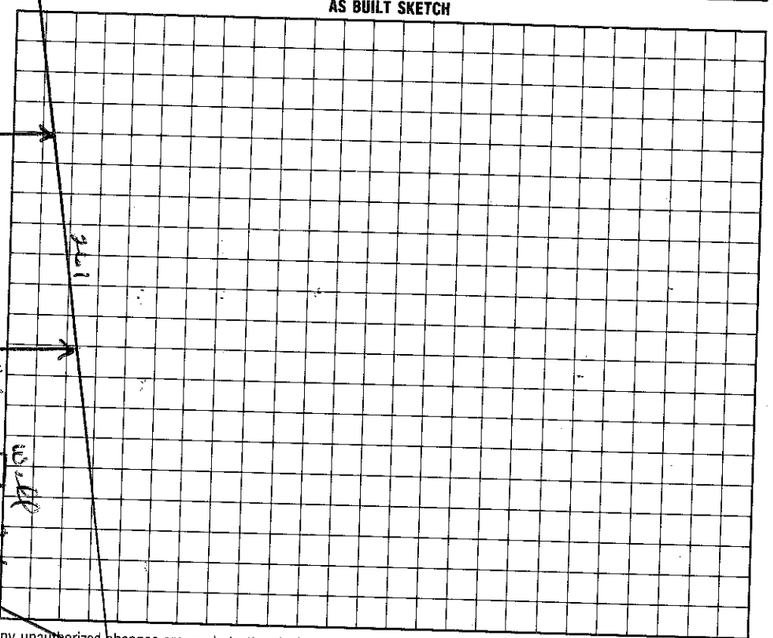

I understand that this permit can be suspended or revoked if any false information is supplied toward securing the permit/any unauthorized changes are made to the site/any unauthorized changes are made in the installation of the system.

Signed: Dave Spencer

Improvement Permit by: Wesley Sparks R.S. date 9/18/95

Existing System Inspection by: date

Installed by: Codyco

Certificate of Completion by: Wesley Sparks R.S. date 11/23/95

Operation Permit by: Wesley Sparks R.S. date

HEALTH DEPT. COPY: WHITE INSPECTION COPY (FINAL): GREEN OWNER COPY (FINAL): YELLOW INSPECTION COPY (INITIAL): PINK OWNER COPY (INITIAL): GOLD