IREDELL COUNTY HEALTH DEPARTMENT

Statesville Office (704) 878-5305 Mooresville Office (704) 660-3625 PERMIT # Repair

IMPROVEMENT PERMIT / AUTHORIZATION TO CONSTRUCT / OPERATION PERMIT / EXISTING SYSTEM

PIN # 4649786841

APPLICANT: Mary Lipe APPLICANT ADDRESS: 172 Rankin Hill Rd Troutman, NC

SITE ADDRESS: 172 Rankin Hill Rd Troutman, NC 28166 PHONE: 704 528 5179 ALT. PHONE:

SITE DIRECTIONS: Us 21 Hwy 115 N. TL Flowerhouse Loop TL Rankin Hill Rd 6th House on Rt.

SUBDIVISION: — SECTION: — LOT # — LOT AREA: 6.46 Ac DESIGN FLOW: 360 gpd L.T.A.R.: —


Septic Tank	1000 (gal)	STB	825	Date	12-17-12	☐ New System	☒ Repair	☐ Expansion	System Type: I	II	III IV V VI
Pump Tank	(gal)	PT		Date		System Description:	Gravity-Conventional				
Pump Make		Model		Serial #		Repair System Description:	Same				
# Nitrification Fields	# Lines	Existing		Linear Ft:	~160ft	Maintenance Agreement Required:	☐ YES	☒ NO			
Trench Width	Max. Trench Bottom Depth			Gravel Depth	12" ?	☒ GRAVITY	☐ PRESSURE				

☒ Residence	No. Bedrooms	3	Water Supply		
☐ Business	No. Persons		☒ Private		
☐ Other	No. Employees		☐ Public		
☐ Slab	☐ Crawl Space		☐ Community		
☐ Basement w/ plumbing			☐ Basement w/o plumbing		

Comments / Conditions: ~~Replace~~ Existing Septic Tank (ST) with new ST. Must be at least 50ft from existing well & >5ft from House.

Use existing Gravity-Conventional (Gravel) Drainfield. House built 1953

INITIAL SITE SKETCH

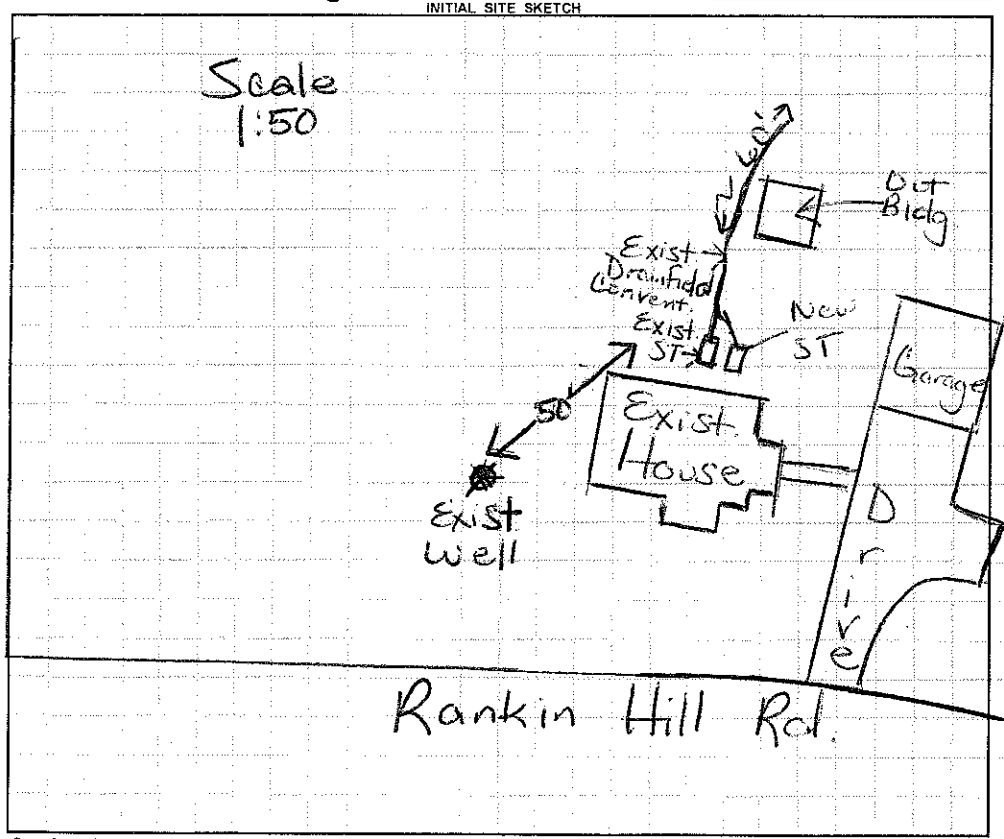

AS BUILT SKETCH

Exist Drainfield Concrete pipe

Permit can be suspended or revoked if any false information is supplied toward securing the permit / any unauthorized changes are made to the site / any unauthorized changes are made in the installation of the system. **CONTACT A LOCATOR SERVICE PRIOR TO ANY EXCAVATION**

☐ **IMPROVEMENT PERMIT** *with plat* valid without expiration. ☐ **IMPROVEMENT PERMIT** *with site plan* valid for 60 mos. ☐ **AUTHORIZATION TO CONSTRUCT** valid for period equal to IMPROVEMENT PERMIT--not to exceed 60 mo.

Owner / Applicant Signature: X Mary M Lipe Date:

IMPROVEMENT PERMIT by: Maintain Dotson RS Date: 1/23/13

AUTHORIZATION TO CONSTRUCT by: Maintain Dotson RS Date: 1/23/13

Installed by: Randy Melton RS Piedmont Septic

OPERATION PERMIT by: Maintain Dotson Date: 2/4/13

Existing System Inspected by: Date:

Health Dept. Copy - WHITE Applicant (Final Approval) - YELLOW Applicant (Conditional Approval) - PINK