4649787354

IREDELL COUNTY HEALTH DEPARTMENT 4th Const. STATESVILLE 704-878-5305 MOORESVILLE 704-664-5281

IMPROVEMENT PERMIT / ~~CERTIFICATE OF COMPLETION~~ / OPERATION PERMIT / EXISTING SYSTEM INSPECTION

PROPERTY DESCRIPTION NO. 23008 DATE March 4, '96 TAX MAP NO. part of 4FB64 Watershed: ☐ Yes ☐ No

OWNER OR CONTRACTOR Donald J. Williams PHONE: Business _____ Home _____

ADDRESS 172 Rankin Hill Rd. Troutman (1080 Charlotte Hwy - Troutman)

LOCATION 115-21 N. TL Flower House Loop TL Rankin Hill Rd. ~ 1/4 mile on right

SUBDIVISION _____ BLOCK / SECTION _____ LOT _____ LOT AREA ~.6 Ac SITE CLASS. _____ DESIGN FLOW 360 gpd L.T.A.R. 13

Septic Tank: 1000 Gallons; STB 794 Date 1/24/96

Pump Tank: _____ Gallons; PT _____ Date _____

Pump Make: _____ Model _____ Serial No. _____

Nitrification Field: No Fields 1 Square Feet 1200 Linear Feet 400

No Lines 4@100 Trench Width 36" Max Trench Bottom Depth 24" Gravel Depth 12"

☑ New System ☐ Repair System Type: I, II, III, IV, V, VI

System Description: gravity conventional

Repair System Description: same

Maintenance Agreement Required: ☐ Yes ☑ No

☐ House/Mod. Home ☑ Mobile Home ☐ Business ☐ Other

No. Bedrooms 3 No. Bathrooms 2 No. Employees ____

☐ Slab ☑ Crawl Space ☐ Basement w/plumbing ☐ Basement wo/plumbing


Water Supply: ☑ Individual ☐ Community ☐ Public

Comments:
3-6-96 - Mr. Williams called and asked if he could eliminate deck and move MH back off street the distance shown for deck.

Comments:
OK DRH

1"=50'

INITIAL SITE SKETCH

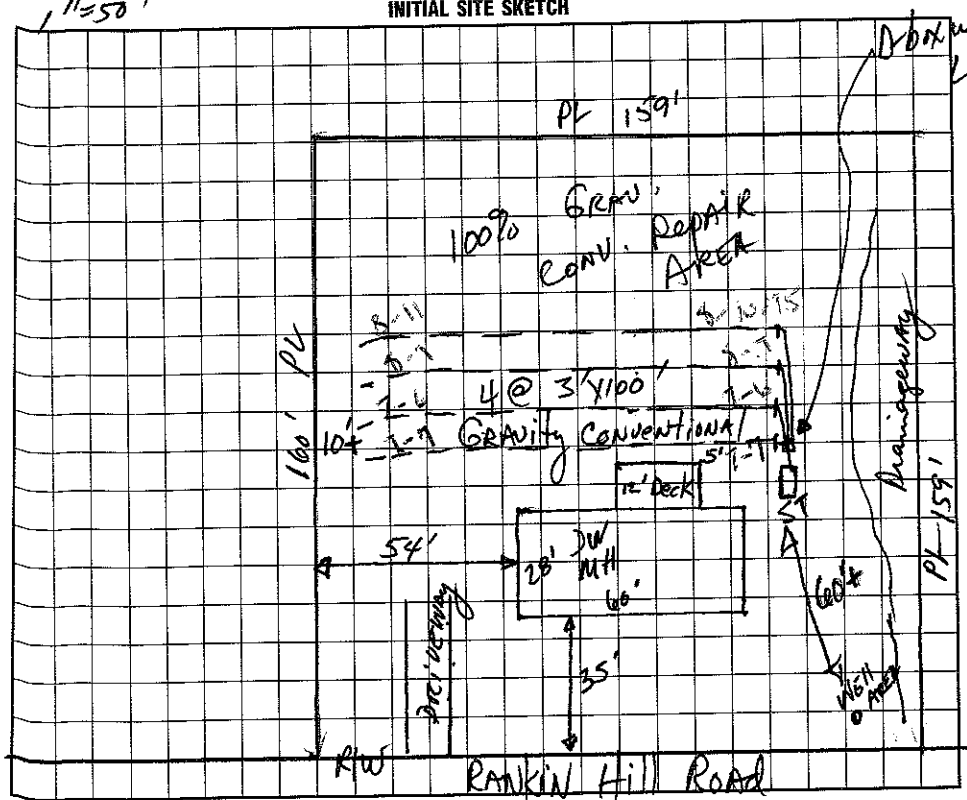

AS BUILT SKETCH

I understand that this permit can be suspended or revoked if any false information is supplied toward securing the permit/any unauthorized changes are made to the site/any unauthorized changes are made in the installation of the system.

Signed: X Donald J. Williams

Improvement Permit by: [signature], RS date 3-4-96

~~Authorization~~ Existing System Inspection by: [signature], RS date 3-4-96

TL Construction

Installed by: Dewayne Gilchrist

Certificate of Completion by: _____ date _____

Operation Permit by: Wesley Sparks R.S. date 4/24/96

APPLICANT COPY: WHITE INSPECTION COPY (FINAL): GREEN OWNER COPY (FINAL): YELLOW INSPECTION COPY (INITIAL): PINK OWNER COPY (INITIAL): GOLD