4649893755

IREDELL COUNTY HEALTH DEPARTMENT → Authorization to Construct

STATESVILLE 704-878-5305 MOORESVILLE 704-664-5281

IMPROVEMENT PERMIT / ~~CERTIFICATE OF COMPLETION~~ / OPERATION PERMIT / EXISTING SYSTEM INSPECTION

PROPERTY DESCRIPTION NO. 23796 DATE 5/21/96 TAX MAP NO. 4F-B-141 Watershed: ☒ Yes ☐ No

OWNER OR CONTRACTOR Chad Paxton PHONE: Business ______ Home 948-9567

ADDRESS 14018 Rodleston Rd Huntersville 28078

LOCATION 21 N - TL Flowerhouse Loop - TL Paxton Hill Rd - 3rd Drive on Rt.

SUBDIVISION — BLOCK / SECTION — LOT — LOT AREA 12 ac SITE CLASS. PS DESIGN FLOW 360 gpd L.T.A.R. .3 gal/ft²

Septic Tank: 1000 Gallons; STB 825 Date 4-1-96

Pump Tank: ______ Gallons; PT ______ Date ______

Pump Make: ______ Model ______ Serial No. ______

Nitrification Field: No Fields 1 Square Feet 1200 Linear Feet 400

No Lines 4 Trench Width 36" Max Trench Bottom Depth 36" Gravel Depth 12"

☒ New System ☐ Repair System Type: I, II, III, IV, V, VI (II circled)

System Description: Gravity Conventional scheme

Repair System Description: ______

Maintenance Agreement Required: ☐ Yes ☒ No

☐ House/Mod. Home ☒ Mobile Home ☐ Business ☐ Other ______

No. Bedrooms 3 No. Bathrooms 2 No. Employees ______


☐ Slab ☒ Crawl Space ☐ Basement w/plumbing ☐ Basement wo/plumbing

Water Supply: ☒ Individual ☐ Community ☐ Public


Comments:

Comments:

Not to Scale **INITIAL SITE SKETCH**

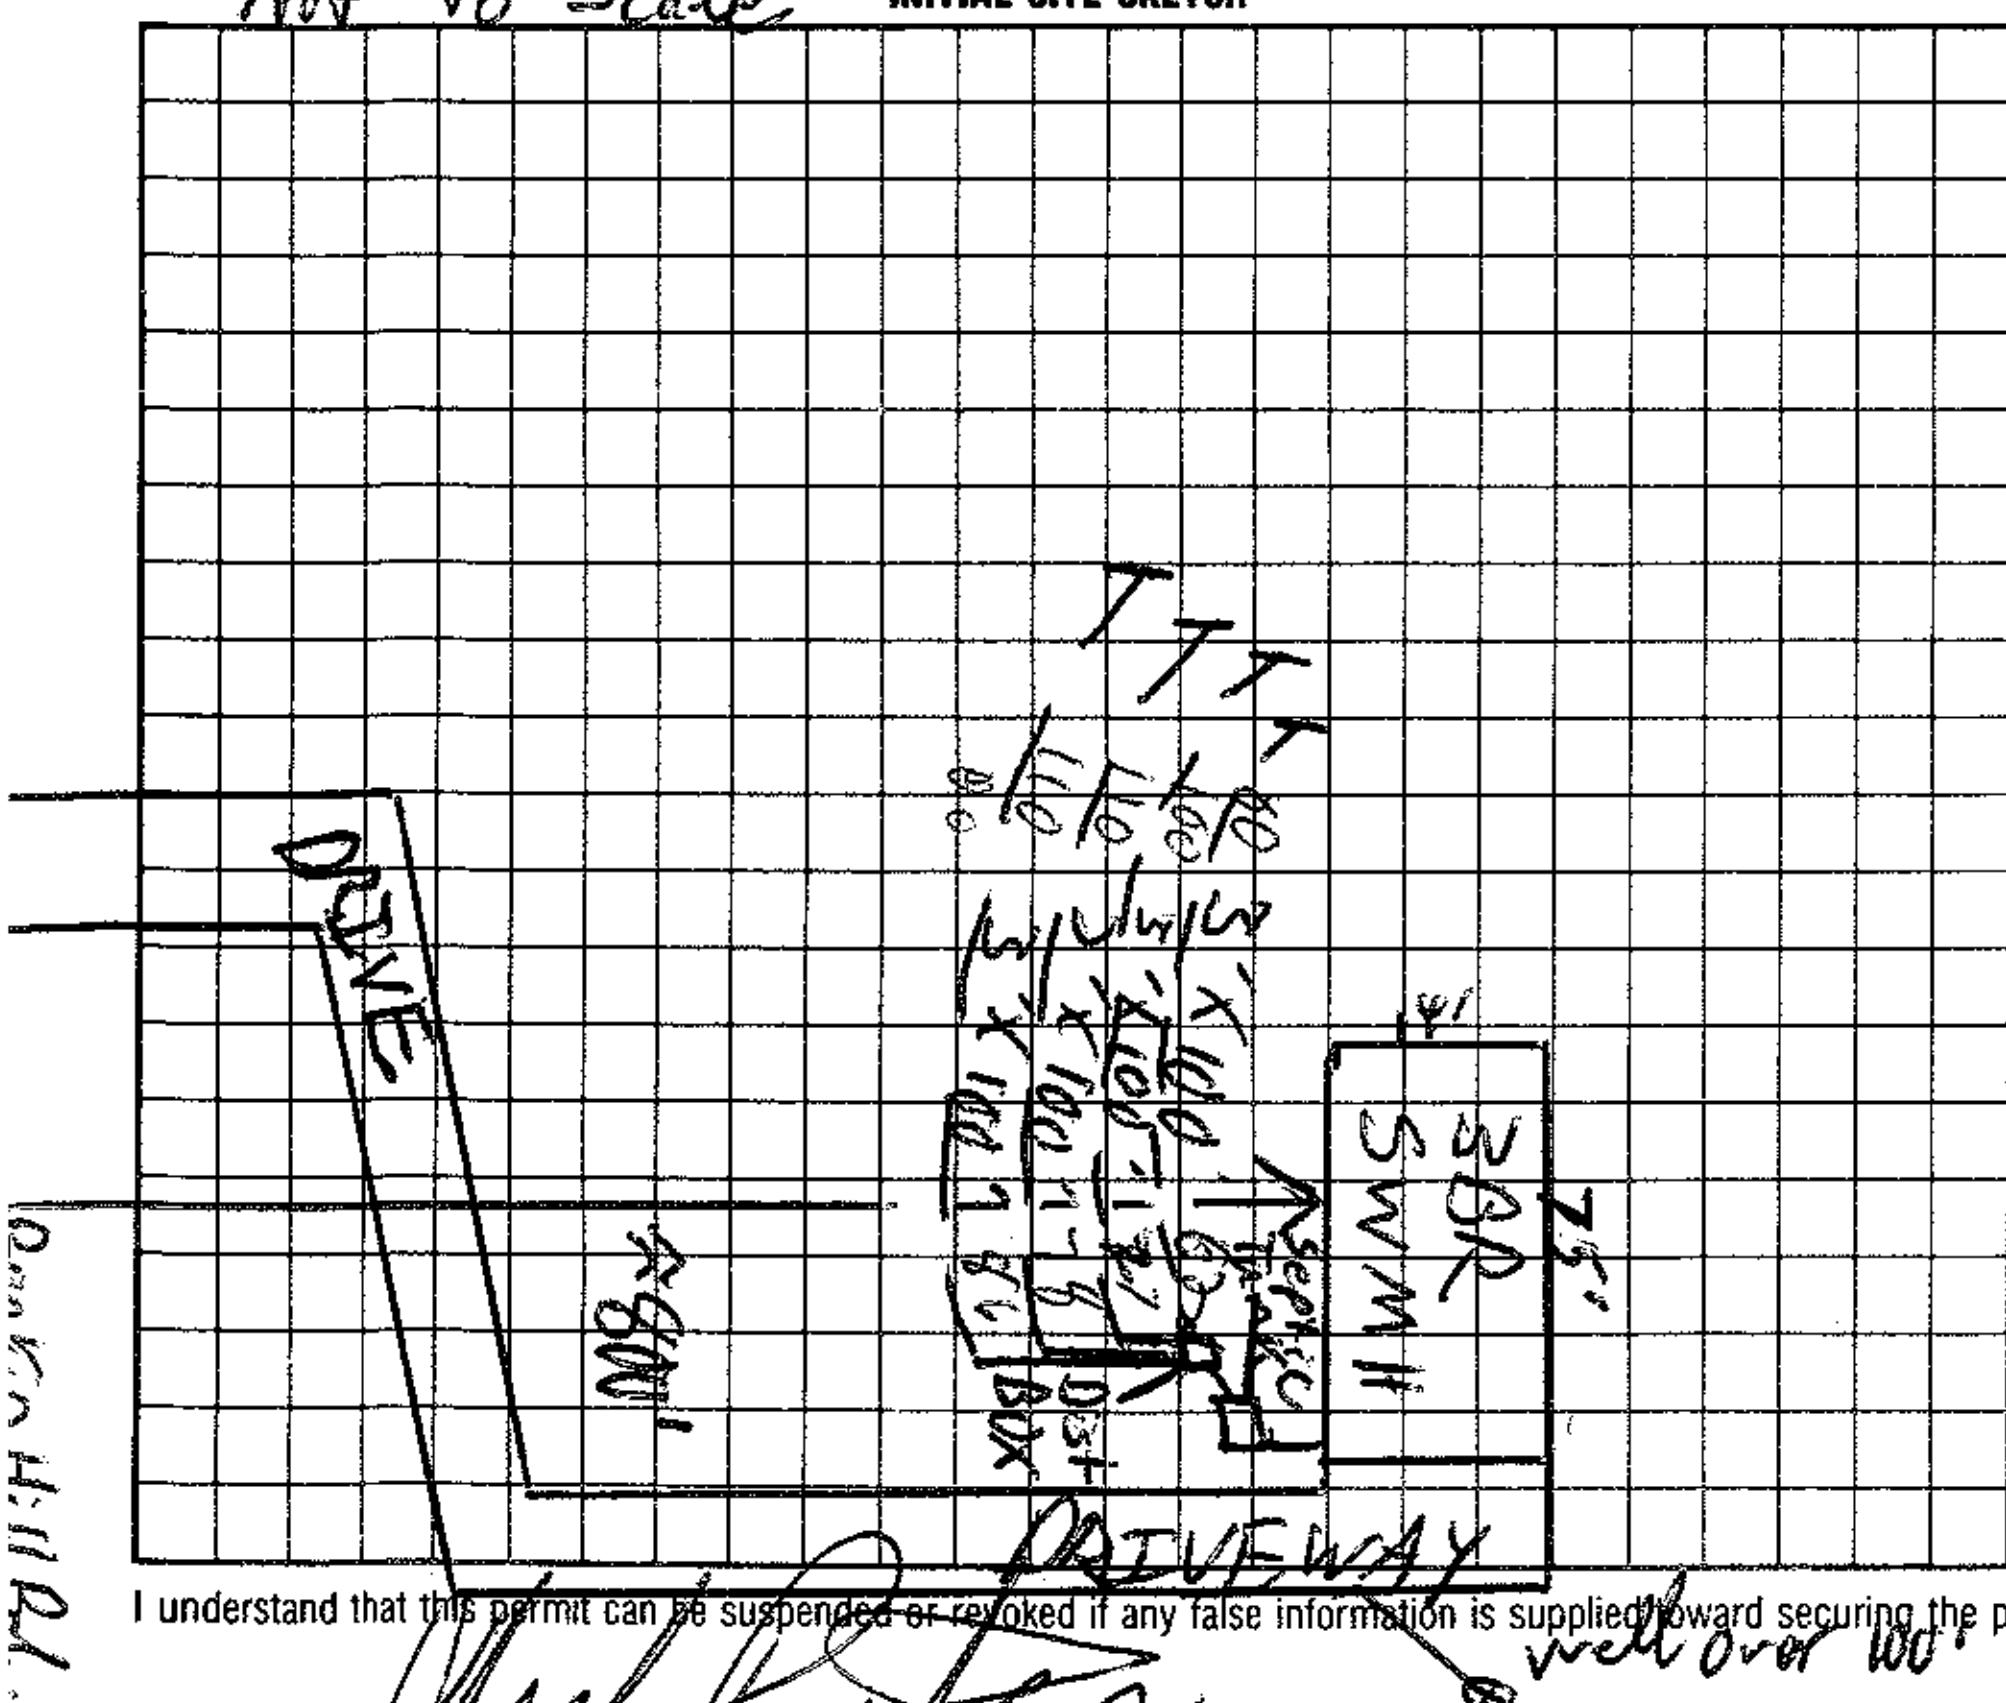

AS BUILT SKETCH

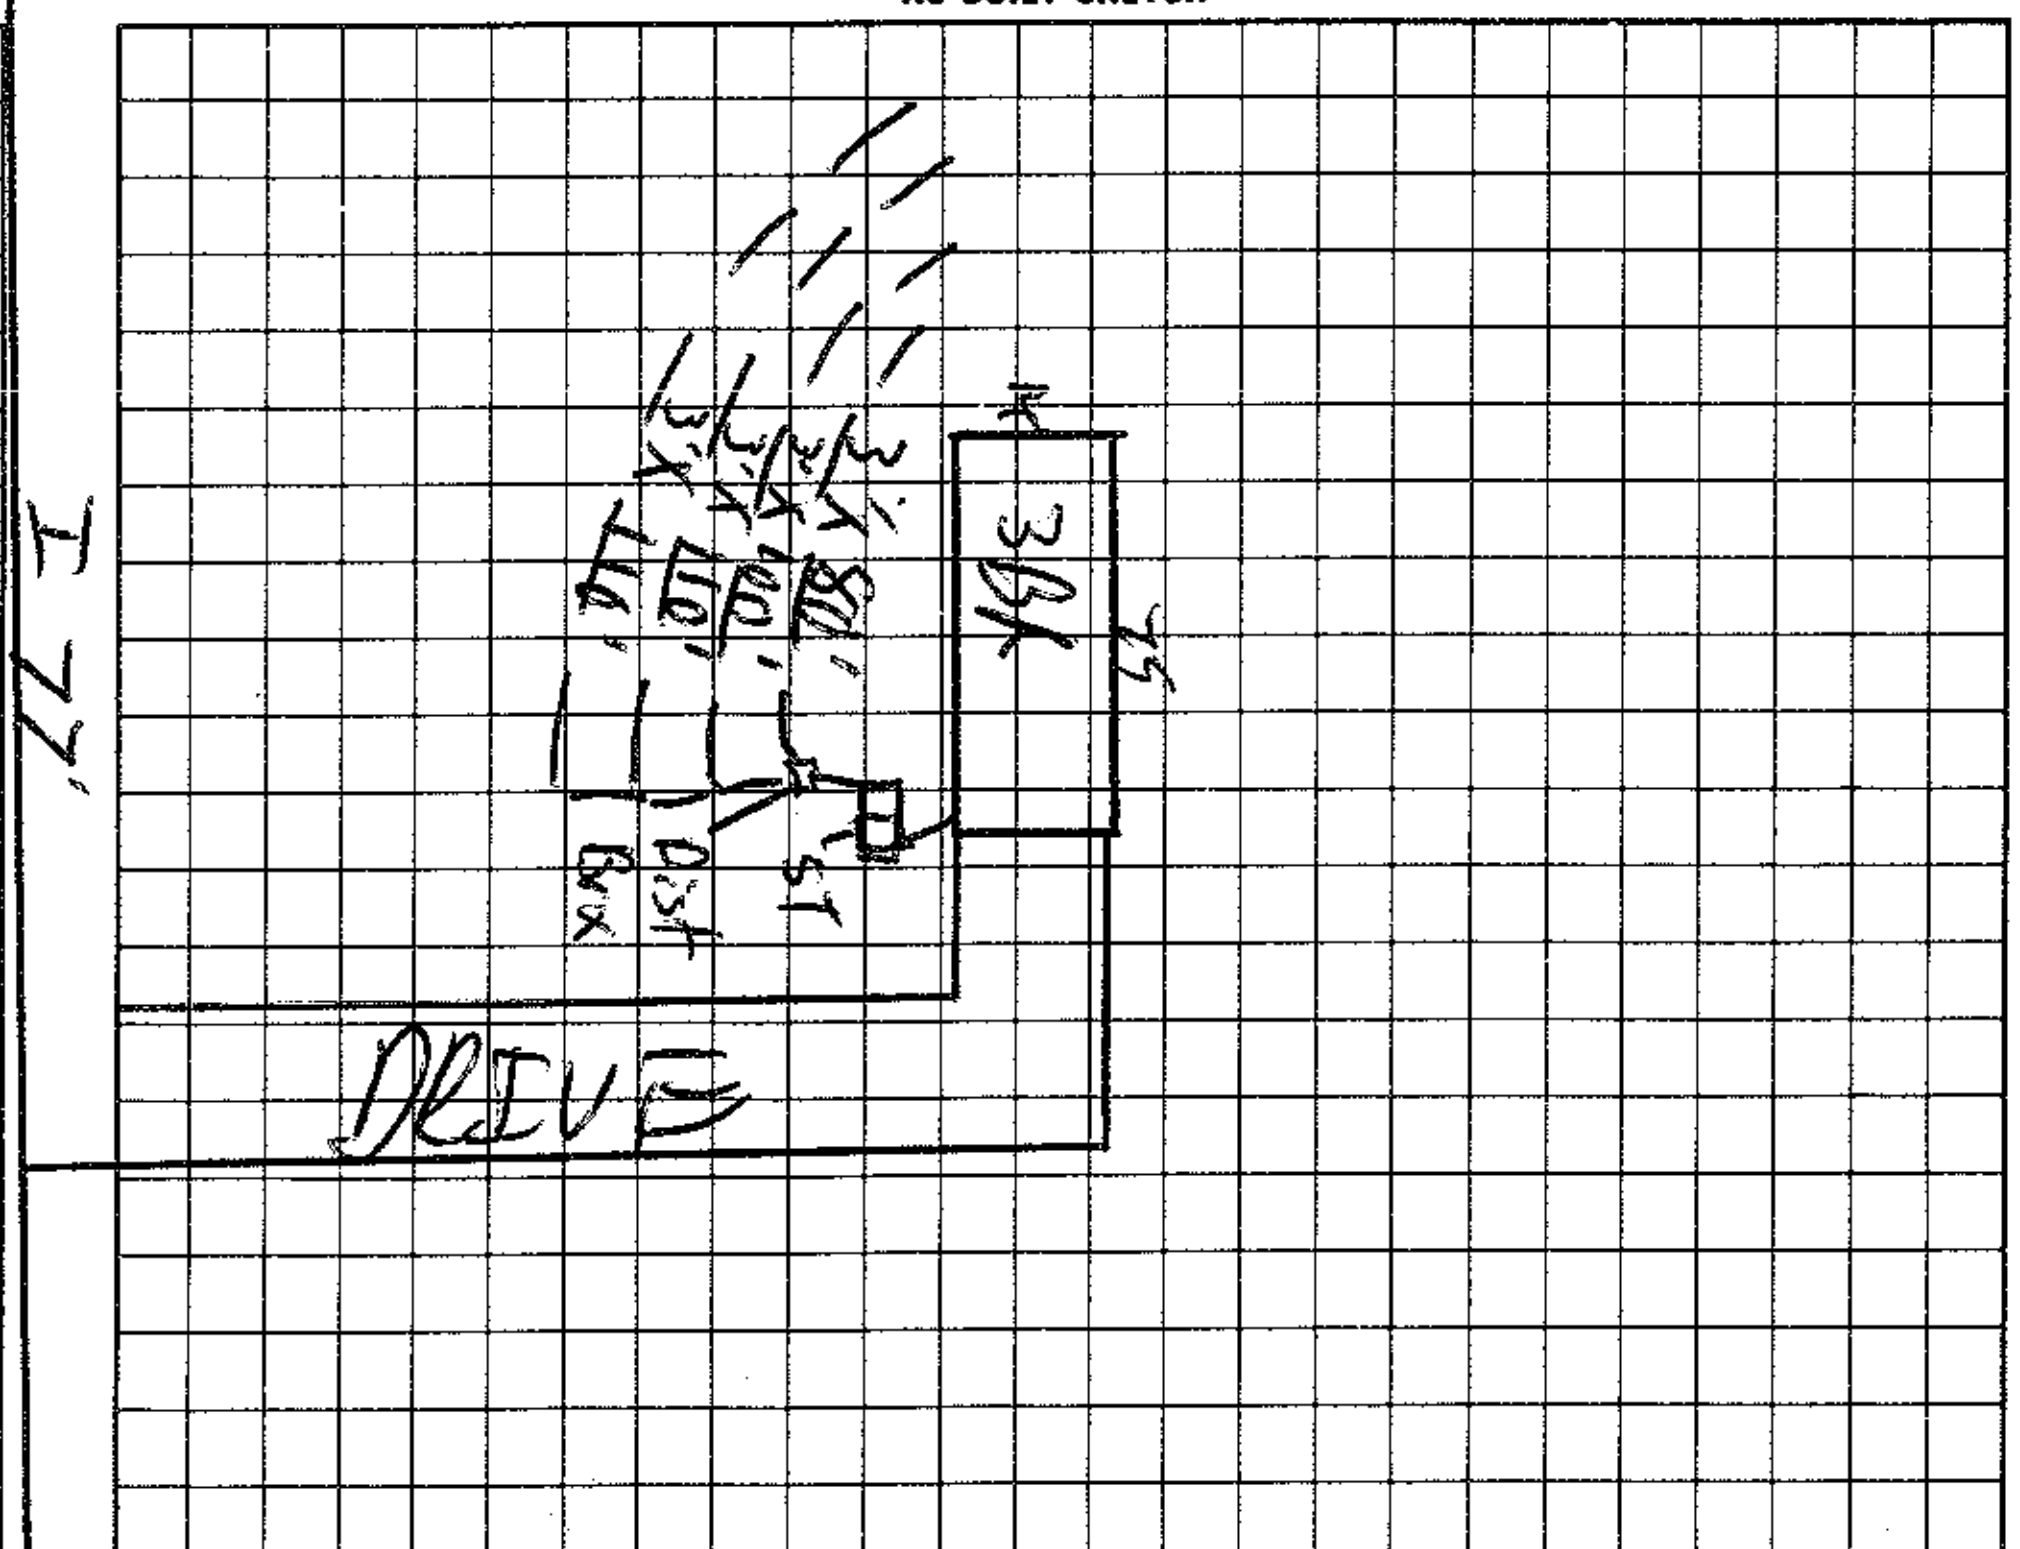

I understand that this permit can be suspended or revoked if any false information is supplied toward securing the permit/any unauthorized changes are made to the site/any unauthorized changes are made in the installation of the system.

Signed: [signature]

Installed by: Webster Landscaping

Improvement Permit by: C. Bradshaw EHSP date 5/21/96

Certificate of Completion by: ______ date ______

Existing System Inspection by: C. Bradshaw EHSP date 5/21/96

Operation Permit by: C. Bradshaw EHSP date 5/24/96

HEALTH DEPT. COPY: WHITE INSPECTION COPY (FINAL): GREEN OWNER COPY (FINAL): YELLOW INSPECTION COPY (INITIAL): PINK OWNER COPY (INITIAL): GOLD

Authorization to Construct is valid for 60 months from issue date

Beside #180

[illegible] H:11 RL