IREDELL COUNTY HEALTH DEPARTMENT

Statesville Office (704) 878-5305 | Mooresville Office (704) 660-3625 | PERMIT # 219203

IMPROVEMENT PERMIT / AUTHORIZATION TO CONSTRUCT / OPERATION PERMIT / EXISTING SYSTEM

PIN # 4649801741

APPLICANT: Dwight Allen Neill | APPLICANT ADDRESS: 128 Dry Dock Lp Mooresville, NC. 28117

SITE ADDRESS: 4430 Barfield Rd Mooresville, NC. 28117 | PHONE: 7046064-4304 | ALT. PHONE: 704 634-2769

SITE DIRECTIONS: US 21/Hwy 115 N TL Barfield Rd on right near end.

SUBDIVISION: ✓ | SECTION: — | LOT # — | LOT AREA: 5.84 Ac | DESIGN FLOW: 360gpd | L.T.A.R.: .3

Septic Tank	1600 (gal)	STB	794	Date	9-21-16	[X] New System	[ ] Repair	[ ] Expansion	System Type: I II (III) IV V VI
Pump Tank	(gal)	PT		Date		System Description:	Gravity – 25% Reduction		
Pump Make		Model		Serial #		Repair System Description:	Grav/Pump 25% Reduction		
# Nitrification Fields	1	# Lines	3	Linear Ft:	300'	Maintenance Agreement Required:	[ ] YES	[X] NO	
Trench Width	36"	Max. Trench Bottom Depth	36"	Gravel Depth	N/A	[X] GRAVITY	[ ] PRESSURE		


[X] Residence | No. Bedrooms 3 | [X] Private Water Supply
[ ] Business | No. Persons 6 | [ ] Public
[ ] Other | No. Employees | [ ] Community
[ ] Slab | [X] Crawl Space
[ ] Basement w/plumbing | [ ] Basement w/o plumbing

Comments / Conditions:

AICHD recommends you "properly" abandon existing ST

Serial distribution

INITIAL SITE SKETCH

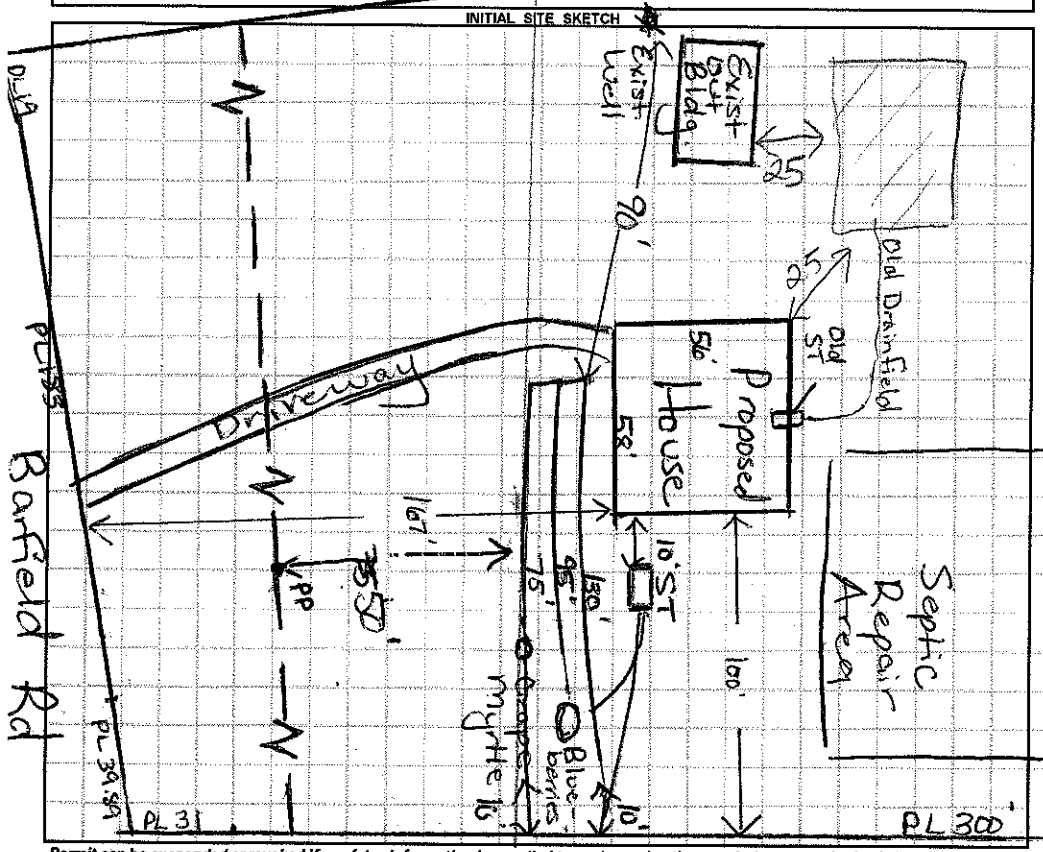

AS BUILT SKETCH

Scale 1:60

10/26/16 Note: Layout backwards
Top line 75', 2nd 95'
Lowest line 130'.

10/26/16 Checked tanks MO

Used Quick 4

Permit can be suspended or revoked if any false information is supplied toward securing the permit / any unauthorized changes are made to the site / any unauthorized changes are made in the installation of the system. **CONTACT A LOCATOR SERVICE PRIOR TO ANY EXCAVATION**

[ ] **IMPROVEMENT PERMIT** *with plat valid without expiration.* [ ] **IMPROVEMENT PERMIT** *with site plan valid for 60 mos.* [ ] **AUTHORIZATION TO CONSTRUCT** *valid for period equal to IMPROVEMENT PERMIT--not to exceed 60 mo.*

Owner / Applicant Signature: Dwight Neill Date: 7/20/16

IMPROVEMENT PERMIT by: Marian Dotson RS Date: 7/14/16

AUTHORIZATION TO CONSTRUCT by: Marian Dotson RS Date: 7/18/16

Installed by: PL Larry Beam

OPERATION PERMIT by: Marian Dotson RS Date: 10/27/16

Existing System Inspected by: Date:

Health Dept. Copy - WHITE | Applicant (Final Approval) - YELLOW | Applicant (Conditional Approval) - PINK