4649 805210

IREDELL COUNTY HEALTH DEPARTMENT

STATESVILLE 704-878-5305 MOORESVILLE 704-664-5281

IMPROVEMENT PERMIT / CERTIFICATE OF COMPLETION / OPERATION PERMIT / EXISTING SYSTEM INSPECT

PROPERTY DESCRIPTION NO. ~~2RA7~~ 20908 DATE May 3, '95 TAX MAP NO. 2RA7 Watershed: ☐ Yes ☐ ...

OWNER OR CONTRACTOR Tamara N. Swaney PHONE: Business _____ Home _____

ADDRESS 145 Henderson Dr, Statesville

LOCATION 115-21N part Shepherd School TL Barfield Rd a 1½ miles on left

SUBDIVISION _____ BLOCK / SECTION _____ LOT _____ LOT AREA 1.83Ac SITE CLASS. PS DESIGN FLOW 240gpd L.T.A.R. .03

Septic Tank: 1000 Gallons; STB 760 Date 3/16/95

Pump Tank: _____ Gallons; PT _____ Date _____

Pump Make: _____ Model _____ Serial No. _____

Nitrification Field: No Fields 1 Square Feet 800 Linear Feet 267

No Lines 3 Trench Width 36" Max Trench Bottom Depth 36" Gravel Depth 12"

☑ New System ☐ Repair System Type: I, II, III, IV, V, VI

System Description: Gravity Conventional

Repair System Description: Same

Maintenance Agreement Required: ☐ Yes ☑ No

☐ House/Mod. Home ☑ Mobile Home ☐ Business ☐ Other

No. Bedrooms 2 No. Bathrooms 2 No. Employees _____


☐ Slab ☑ Crawl Space ☐ Basement w/plumbing ☐ Basement wo/plumbing

Water Supply: ☑ Individual ☐ Community ☐ Public Well on adjacent Property


Comments: Remove - grade old drainage trench in Barfield area. Follow contours w/ details

Comments: Installed as drawn.

INITIAL SITE SKETCH

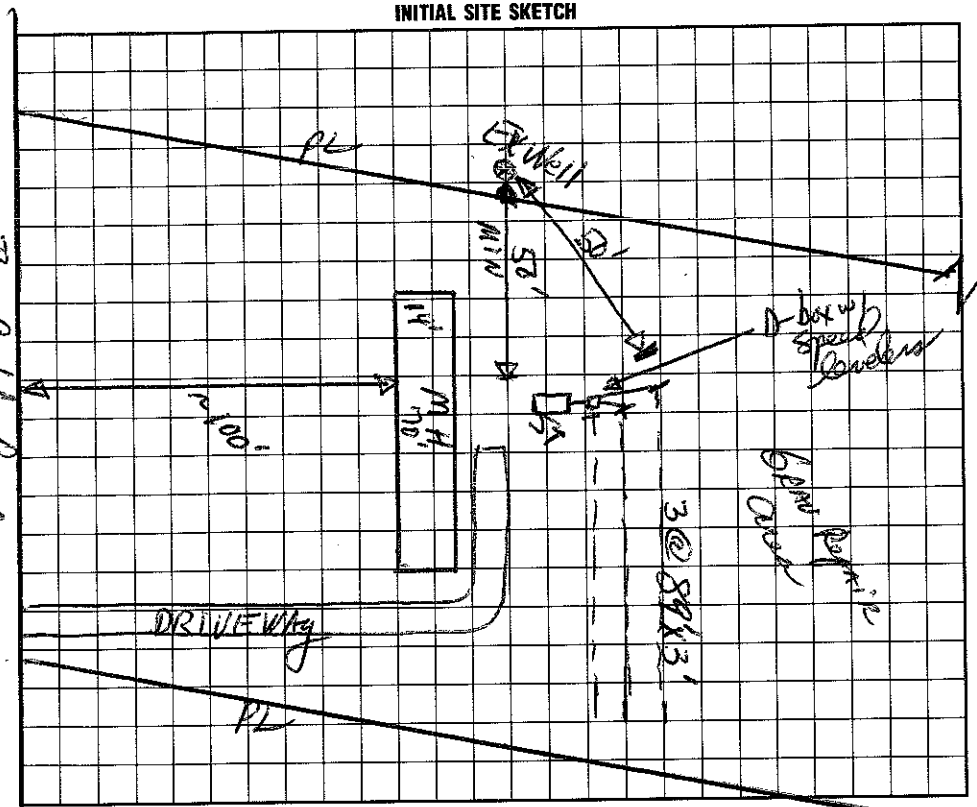

AS BUILT SKETCH

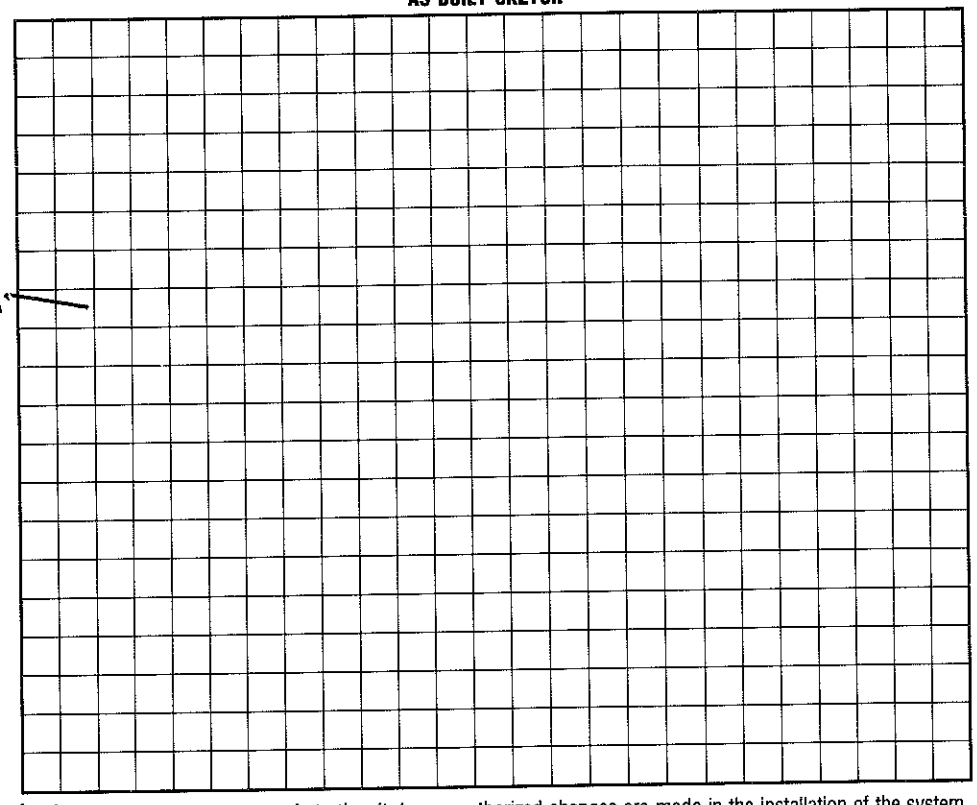

I understand that this permit can be suspended or revoked if any false information is supplied toward securing the permit/any unauthorized changes are made to the site/any unauthorized changes are made in the installation of the system. Improvement Permit is valid for 60 months from date of issuance.

Signed: Tamara N. Swaney

Improvement Permit by: Jerald Hammond, RS date 5/3/95

Existing System Inspection by: _____ date _____

Installed by: Long Powell

Certificate of Completion by: Wesley Sparks RS. date 5/5/95

Operation Permit by: _____ date _____

HEALTH DEPT. COPY: WHITE INSPECTION COPY (FINAL): GREEN OWNER COPY (FINAL): YELLOW INSPECTION COPY (INITIAL): PINK OWNER COPY (INITIAL): GOLD