IREDELL COUNTY HEALTH DEPARTMENT

STATESVILLE 704-878-5305 130.00 Paid MOORESVILLE 704-664-5281

IMPROVEMENT PERMIT / AUTHORIZATION TO CONSTRUCT / OPERATION PERMIT / EXISTING SYSTEM INSPECTION

PERMIT# 111890 PIN# ~~4649-75-0165.44~~ 4649-85-3687 DATE 2/14/05

OWNER OR CONTRACTOR PRIMESTAR PROPERTIES / FREEDOM HOMES PHONE: Business 932-9100 Home

ADDRESS 1709 S MAIN ST. KANNAPOLIS NC 28081

LOCATION RANKIN HILL - TR MAPLE FOREST - AT END OF LS

SUBDIVISION MAPLE FOREST BLOCK / SECTION 4 LOT 44 LOT AREA 1.324 c SITE CLASS. PS DESIGN FLOW 360GPD L.T.A.R. .36/1.0ac

Septic Tank: 1000 Gallons; STB 760 Date 11/27/06
Pump Tank: Gallons; PT Date
Pump Make: Model Serial No.
Nitrification Field: No Fields 4 Square Feet 400 Linear Feet 300
No Lines 2@150' Trench Width 36" Max Trench Bottom Depth 36" Gravel Depth N/A

☑ New System ☐ Repair System Type: I II III IV V VI
System Description: GRAVITY 25% REDUCTION
Repair System Description: 2 @ PANEL
Maintenance Agreement Required: ☐ Yes ☑ No


☑ House/Mod. Home No. Bedrooms 3
☐ Mobile Home No. Bathrooms 3
☐ Business No. Employees
☐ Other
☐ Slab ☐ Crawl Space ☐ Basement w/plumbing ☐ Basement wo/plumbing

Water Supply: ☑ Individual ☐ Public ☐ Community


Comments:/Conditions:

Comments:/Conditions: longfathom installed

1" = 60' INITIAL SITE SKETCH

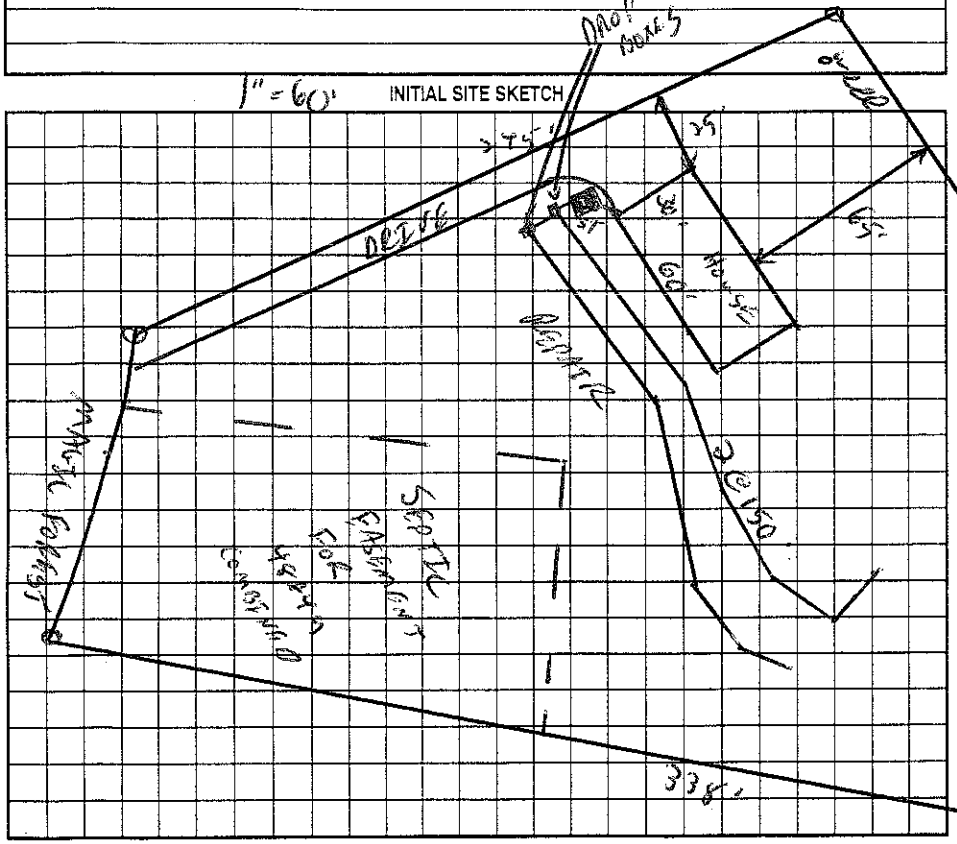

AS BUILT SKETCH

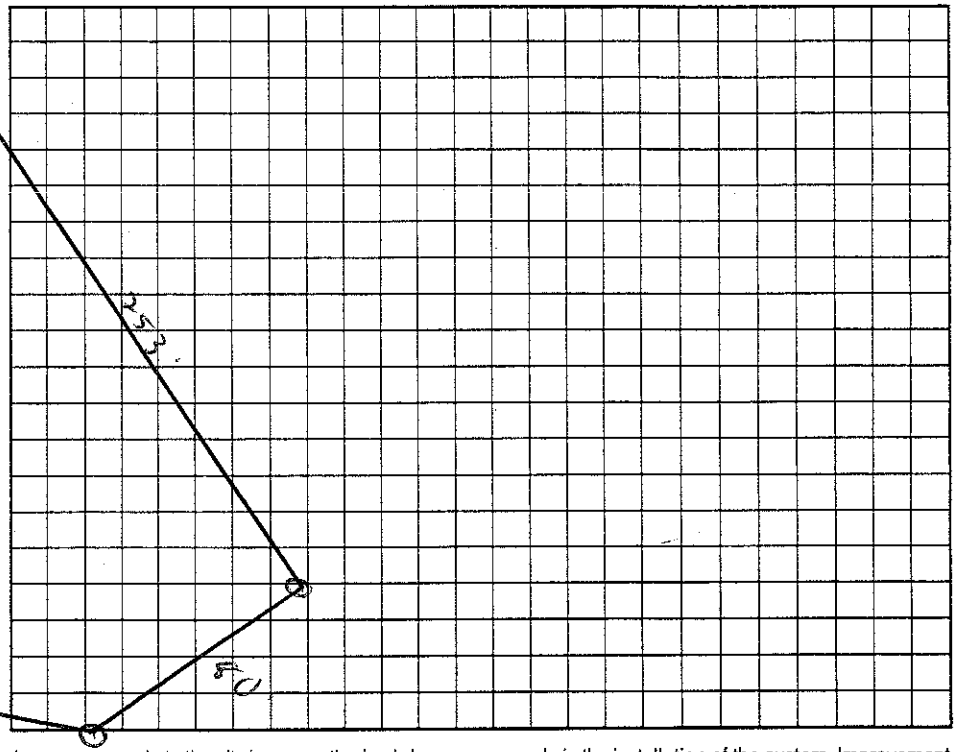

Permit can be suspended or revoked if any false information is supplied toward securing the permit/any unauthorized changes are made to the site/any unauthorized changes are made in the installation of the system. Improvement Permit with plat valid without expiration. Improvement Permit with site plan valid for sixty months. Authorization to Construct is valid for a period equal to that of Improvement Permit – not to exceed sixty months.

Signed: date 4/24/05 Installed by:

Improvement Permit by: date 2/14/05 Operation Permit by: Wesley Sparks R.S. date 6/6/06

Authorization to Construct by: Wesley Sparks R.S. date 5/16/06 Existing System Inspection by: date

HEALTH DEPT. COPY: WHITE OWNER COPY (FINAL): YELLOW OWNER COPY (INITIAL): PINK