IREDELL COUNTY HEALTH DEPARTMENT

STATESVILLE 704-878-5305 MOORESVILLE 704-664-5281

IMPROVEMENT PERMIT / AUTHORIZATION TO CONSTRUCT / OPERATION PERMIT / EXISTING SYSTEM INSPECTION

PERMIT# 072462 PIN# 4649 85 3927 DATE 6/2/98

OWNER OR CONTRACTOR Pruitt Dev. Co. PHONE: Business 875-0081 Home

ADDRESS 124 Kirkwall Pl Mooresville, NC.

LOCATION 115 N TL Sailwinds - to end - on (R) off cul de sac

SUBDIVISION Windward Pt. BLOCK / SECTION 2 LOT 106 LOT AREA .96 AC SITE CLASS. PS DESIGN FLOW 480 L.T.A.R. .3

Septic Tank: 1000 Gallons; STB 1612 Date 4/17/98

Pump Tank: 1000 Gallons; PT 17 Date 10/15/97

Pump Make: HYDROMATIC Model SK50A1 Serial No. 4/98

Nitrification Field: No Fields 1 Square Feet 1200* Linear Feet 400*

No Lines 4 Trench Width 36" Max Trench Bottom Depth 30" Gravel Depth SAND

☒ New System ☐ Repair System Type: I, II, (III), IV, V, VI

System Description: PRESMAN — CH PLASTIC

Repair System Description: SAME

Maintenance Agreement Required: ☐ Yes ☒ No

☒ House/Mod. Home No. Bedrooms 4
☐ Mobile Home No. Bathrooms 2.5
☐ Business No. Employees
☐ Other


☐ Slab ☒ Crawl Space ☐ Basement w/plumbing ☐ Basement wo/plumbing

Water Supply: ☒ Individual ☐ Public ☐ Community

Comments:/Conditions: *25% reduction

Comments:/Conditions: No Wall on site

INITIAL SITE SKETCH

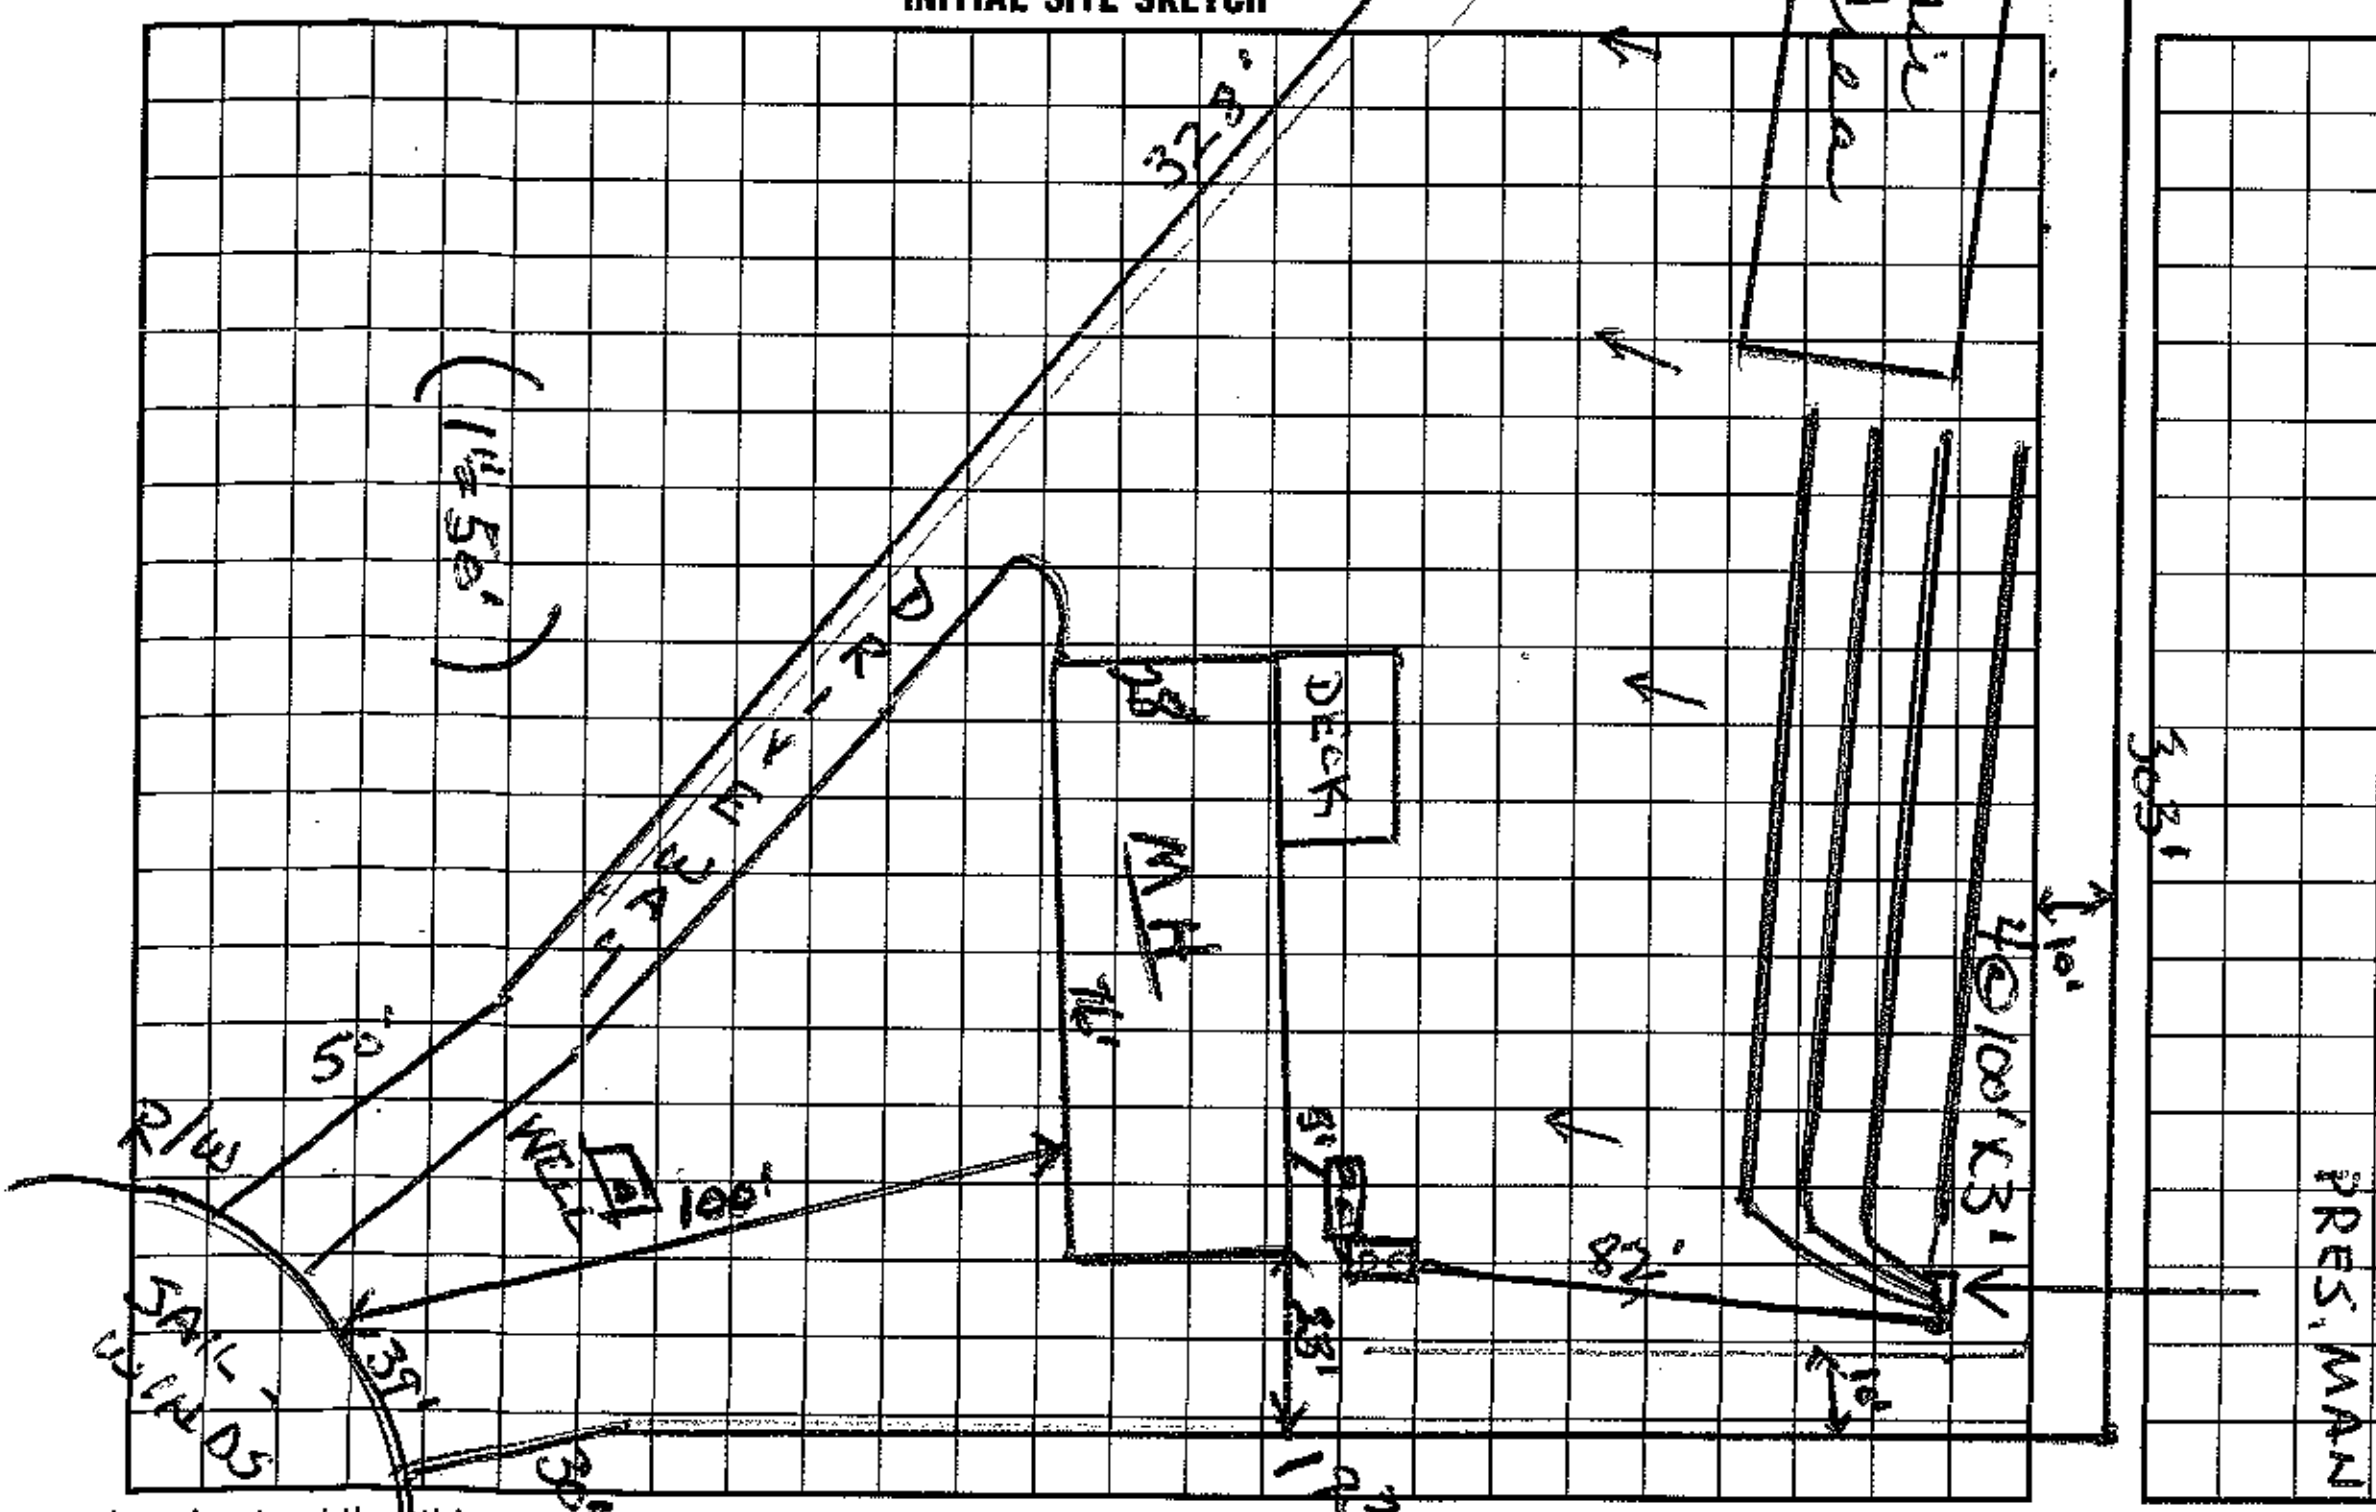

AS BUILT SKETCH

I understand that this permit can be suspended or revoked if any false information is supplied toward securing the permit/any unauthorized changes are made to the site/any unauthorized changes are made in the installation of the system. Improvement Permit with plat valid without expiration. Improvement Permit with site plan valid for sixty months. Authorization to Construct is valid for a period equal to that of Improvement Permit – not to exceed sixty months.

Signed: X [signature] date

Improvement Permit by: Wesley Sparks RS. date 6/2/98

Authorization to Construct by: Wesley Sparks RS. date 6/2/98

Installed by: A-1 Backhoe

Operation Permit by: Wesley Sparks RS. date 8/4/98

Existing System Inspection by: Wesley Sparks RS date 8/4/98

HEALTH DEPT. COPY: WHITE INSPECTION COPY (FINAL): GREEN OWNER COPY (FINAL): YELLOW INSPECTION COPY (INITIAL): PINK OWNER COPY (INITIAL): GOLD