IREDELL COUNTY HEALTH DEPARTMENT

STATESVILLE 704-878-5305 500.00 Paid MOORESVILLE 704-664-5281

IMPROVEMENT PERMIT / AUTHORIZATION TO CONSTRUCT / OPERATION PERMIT / EXISTING SYSTEM INSPECTION

PERMIT# 111919 PIN# 4649 75 0165.47 4649 854131 DATE 12/14/04

OWNER OR CONTRACTOR Fleetwood Homes PHONE: Business 704-528-7129 Home

ADDRESS 1040 Charlotte Hwy. Turnitupon NC.

LOCATION Flower House Lp. Tr Rankin Hill Rd. Tr Magic Forest at cul de sac at end of road

SUBDIVISION Magic Forest BLOCK / SECTION 4 LOT 47 LOT AREA 1.45AC SITE CLASS PS DESIGN FLOW 360 L.T.A.R. .25 - .3

Septic Tank: 1000 Gallons; STB 1012 Date 7/6/04
Pump Tank: 1000 Gallons; PT 17 Date 9/13/04
Pump Make: Gould's Model WE0311M Serial No.
Nitrification Field: No Fields 1 Square Feet 960 Linear Feet 320
No Lines 4 @ 80' Trench Width 3' Max Trench Bottom Depth 30" Gravel Depth No

☒ New System ☐ Repair System Type: I, II, III, IV, V, VI
System Description: PM → 25% Reduced
Repair System Description: 25% Red. (SHALLOW)
Maintenance Agreement Required: ☐ Yes ☒ No

☒ House/Mod. Home No. Bedrooms 3
☐ Mobile Home No. Bathrooms 3
☐ Business No. Employees
☐ Other
☐ Slab ☒ Crawl Space ☐ Basement w/plumbing ☐ Basement wo/plumbing


Water Supply: ☒ Individual ☐ Public ☐ Community

Comments:/Conditions: Keep shallow, maximum trench depth 30"


Comments:/Conditions:

1" = 50'

INITIAL SITE SKETCH

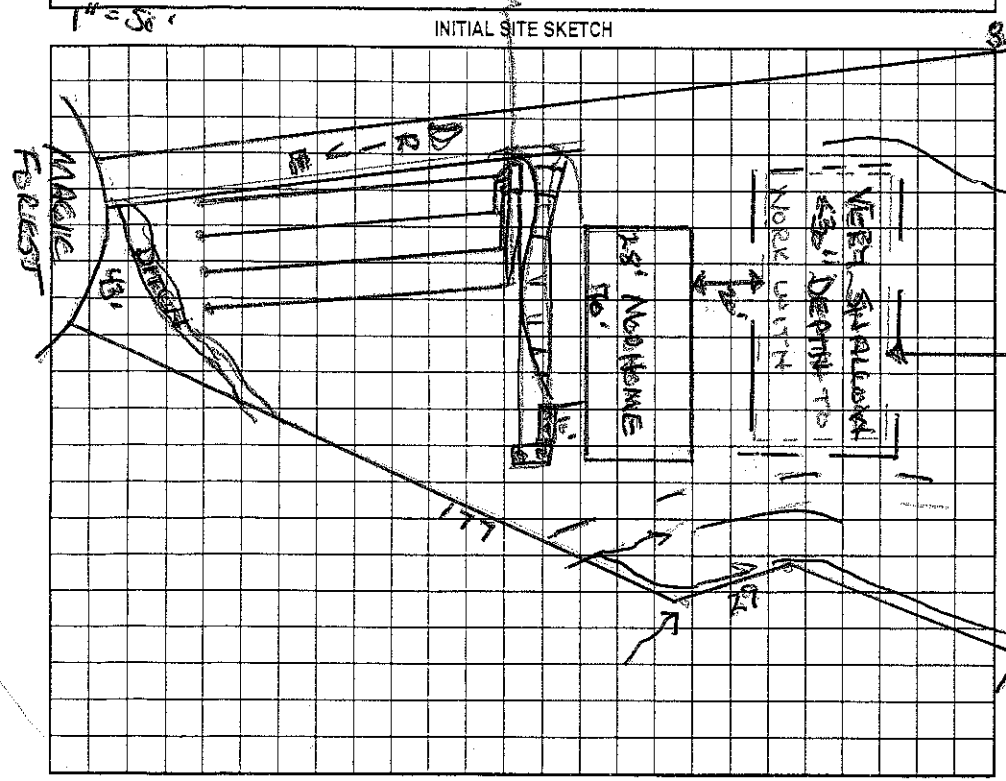

AS BUILT SKETCH

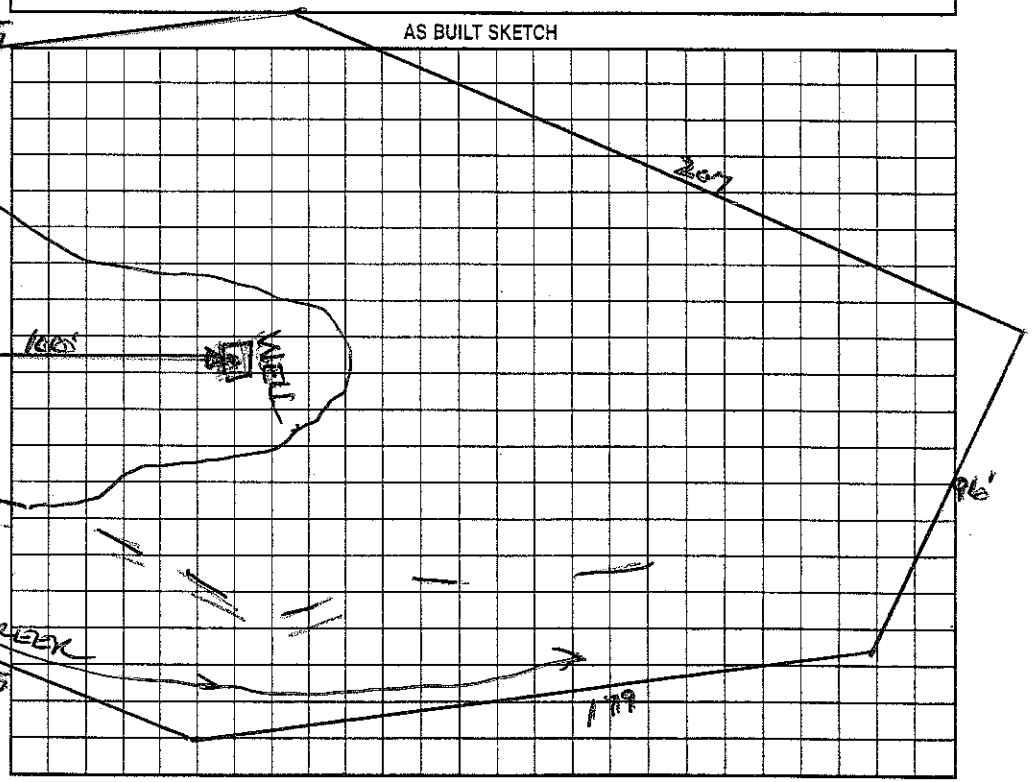

Permit can be suspended or revoked if any false information is supplied toward securing the permit/any unauthorized changes are made to the site/any unauthorized changes are made in the installation of the system. Improvement Permit with plat valid without expiration. Improvement Permit with site plan valid for sixty months. Authorization to Construct is valid for a period equal to that of Improvement Permit – not to exceed sixty months.

Signed: X Dennis Dallas date 12-16-04 Installed by: A1 Backhoe

Improvement Permit by: Wesley Sparks R.S. date 12/14/04 Operation Permit by: Wesley Sparks R.S. date 12/30/04

Authorization to Construct by: Wesley Sparks R.S. date 12/14/04 Existing System Inspection by: date

HEALTH DEPT. COPY: WHITE OWNER COPY (FINAL): YELLOW OWNER COPY (INITIAL): PINK