IREDELL COUNTY HEALTH DEPARTMENT

Statesville Office (704) 878-5305 Mooresville Office (704) 660-3625 PERMIT # 207580

IMPROVEMENT PERMIT / AUTHORIZATION TO CONSTRUCT / OPERATION PERMIT / EXISTING SYSTEM

PIN # 4649-85-4384

APPLICANT: TIMOTHY NAJARIAN APPLICANT ADDRESS: 164 MAGIC FOREST DR.

SITE ADDRESS: SAME PHONE: 610-914-4870 ALT. PHONE:

SITE DIRECTIONS: 21N, TL FLOWERHOUSE, TL RANKINHILL, TL MAGIC FOREST, C END

SUBDIVISION: MAGIC FOREST SECTION: 4 LOT # 46 LOT AREA: .82 AC DESIGN FLOW: 480 L.T.A.R.: .3

Septic Tank Ex.1000 (gal) STB 1012 Date 6-18-04
Pump Tank (gal) PT Date
Pump Make Model Serial #
Nitrification Fields 1 # Lines 2 Linear Ft: 160'
Trench Width 36" Max. Trench Bottom Depth 36" Gravel Depth

☐ New System ☐ Repair ☐ Expansion System Type: I II (III) IV V VI
System Description: 25% REDUCTION
Repair System Description: PANEL BLOCK
Maintenance Agreement Required: ☐ YES ☒ NO
☒ GRAVITY ☐ PRESSURE


☐ Residence ☐ Business ☒ Other ☒ Slab ☐ Basement w/plumbing
No. Bedrooms 4 No. Persons No. Employees ☐ Crawl Space ☐ Basement w/o plumbing

Water Supply: ☒ Private ☐ Public ☐ Community


Comments / Conditions: * GARAGE MUST BE 5' MIN FROM SEPTIC
* LTAR DETERMINED ON PREVIOUS PERMIT (124957)

GARAGE

INITIAL SITE SKETCH

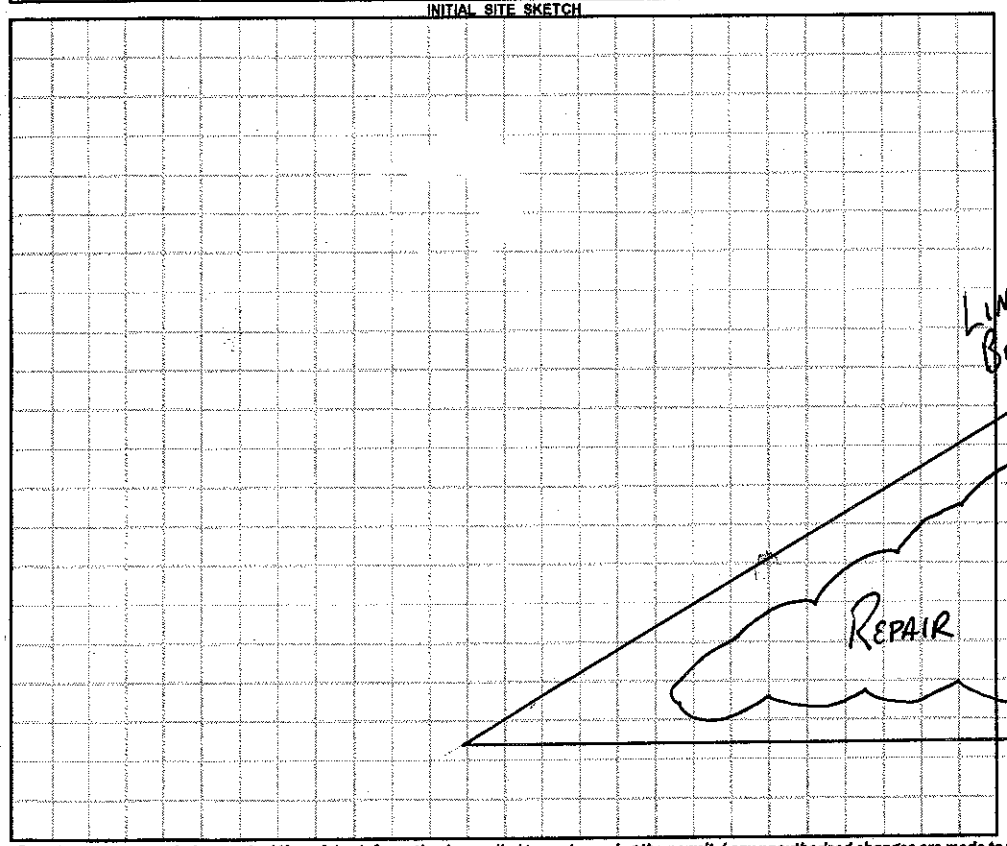

AS BUILT SKETCH

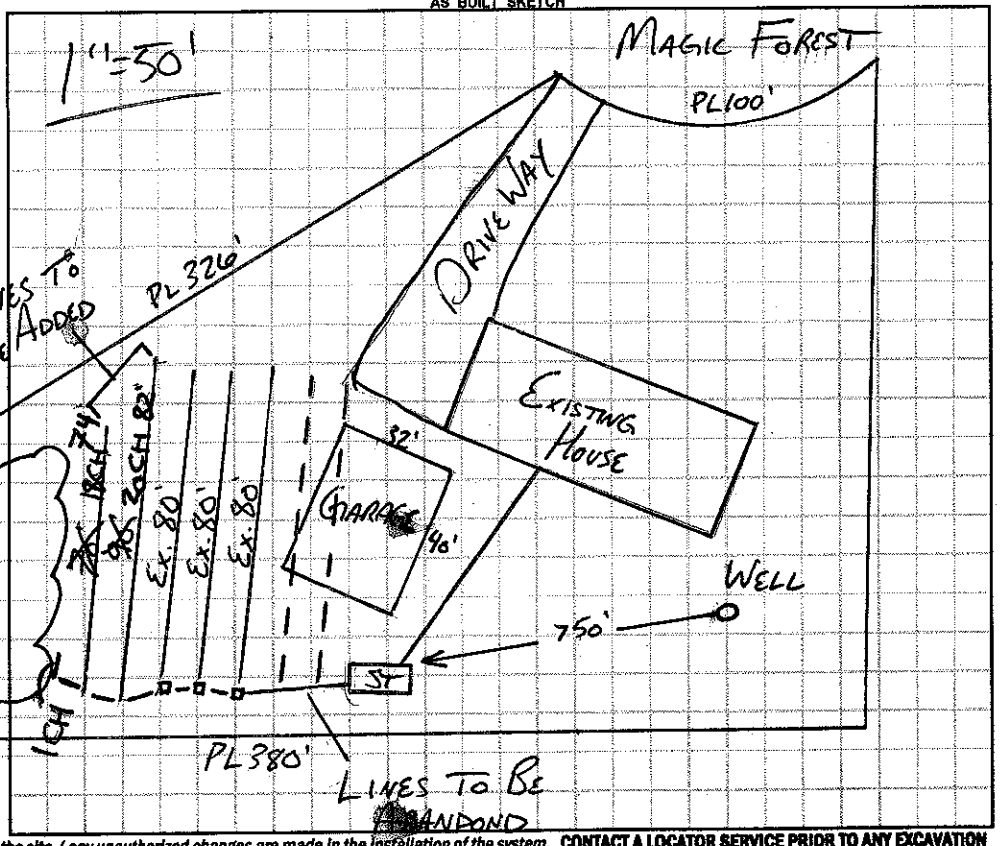

Permit can be suspended or revoked if any false information is supplied toward securing the permit / any unauthorized changes are made to the site / any unauthorized changes are made in the installation of the system. **CONTACT A LOCATOR SERVICE PRIOR TO ANY EXCAVATION**

☐ **IMPROVEMENT PERMIT** *with plat valid without expiration.* ☐ **IMPROVEMENT PERMIT** *with site plan valid for 60 mos.* ☒ **AUTHORIZATION TO CONSTRUCT** *valid for period equal to IMPROVEMENT PERMIT--not to exceed 60 mo.*

Owner / Applicant Signature: Date: Jan 23 2015 Installed by: ST Choice Septic

IMPROVEMENT PERMIT by: Date: JAN 20 2015 OPERATION PERMIT by: Date: 4-7-15

AUTHORIZATION TO CONSTRUCT by: Date: JAN 20 2015 Existing System Inspected by: Date:

Health Dept. Copy - WHITE Applicant (Final Approval) - YELLOW Applicant (Conditional Approval) - PINK