# IREDELL COUNTY HEALTH DEPARTMENT

STATESVILLE 704-878-5305 MOORESVILLE 704-664-5281

## IMPROVEMENT PERMIT / CERTIFICATE OF COMPLETION / OPERATION PERMIT / EXISTING SYSTEM INSPECTION

PROPERTY DESCRIPTION NO. 21390 DATE 6/13/95

OWNER OR CONTRACTOR James P. Riffe TAX MAP NO. 4F 3A 76

ADDRESS 123 Thoroughbred Ln PHONE: Business 4679-86-6687 Home 351-0325 Watershed: ☐ Yes ☒ No

LOCATION

SUBDIVISION Palomino Park BLOCK / SECTION LOT 76 LOT AREA Existg SITE CLASS. P DESIGN FLOW 360 L.T.A.R. 3

Septic Tank: Existg Gallons; STB Date

Pump Tank: Gallons; PT Date

Pump Make: Model Serial No.

Nitrification Field: No Fields Square Feet Existg System Linear Feet

No Lines Trench Width Max Trench Bottom Depth Gravel Depth

☐ New System ☐ Repair System Type: I, II, III, IV, V, VI

System Description: Existg System

Repair System Description:

Maintenance Agreement Required: ☐ Yes ☐ No

☒ House/Mod. Home No. Bedrooms 3

☐ Mobile Home No. Bathrooms 2

☐ Business No. Employees

☐ Other


☐ Slab ☒ Crawl Space ☐ Basement w/plumbing ☐ Basement wo/plumbing

Water Supply:
☒ Individual
☐ Community
☐ Public

Comments:

Comments:

**INITIAL SITE SKETCH**

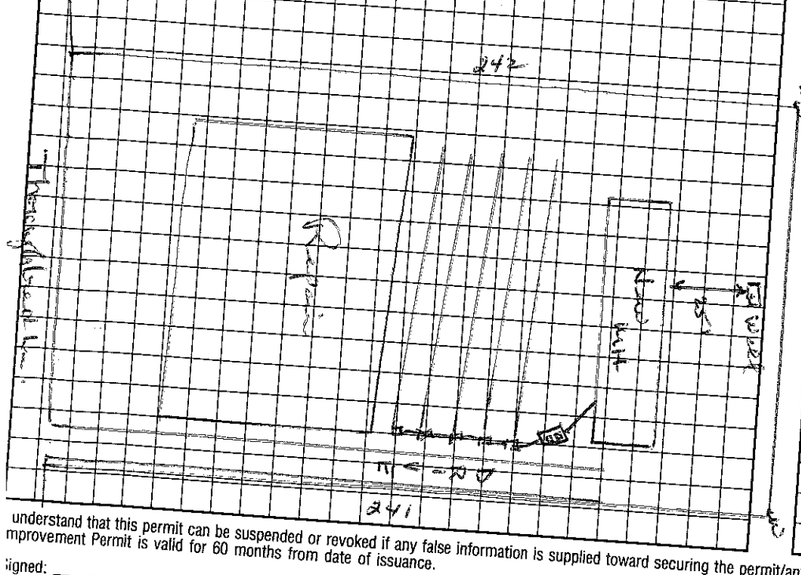


**AS BUILT SKETCH**

I understand that this permit can be suspended or revoked if any false information is supplied toward securing the permit/any unauthorized changes are made to the site/any unauthorized changes are made in the installation of the system. Improvement Permit is valid for 60 months from date of issuance.

Signed:

Improvement Permit by: date

Existing System Inspection by: Wesley Sparks RS, date 6/13/95

Installed by:

Certificate of Completion by: date

Operation Permit by: date

HEALTH DEPT. COPY: WHITE INSPECTION COPY (FINAL): GREEN OWNER COPY (FINAL): YELLOW INSPECTION COPY (INITIAL): PINK OWNER COPY (INITIAL): GOLD

# IREDELL COUNTY HEALTH DEPARTMENT

STATESVILLE 704-878-5305 MOORESVILLE 704-664-5281

## IMPROVEMENT PERMIT / CERTIFICATE OF COMPLETION / OPERATION PERMIT / EXISTING SYSTEM INSPECTION

PROPERTY DESCRIPTION NO. 16239 DATE 6/24/94 TAX MAP NO. 4F 3A 76

OWNER OR CONTRACTOR Lula Deam Clark PHONE: Business 663-2142 Home Watershed: ☐ Yes ☒ No

ADDRESS 326 Caldwell St. Mooresville, NC. 28115

LOCATION Thoroughbred Ln.

SUBDIVISION Palomino Park BLOCK / SECTION LOT 76 LOT AREA ~ .6AC SITE CLASS. P DESIGN FLOW 360 L.T.A.R. .25

Septic Tank: 1000 Gallons; STB 1012 Date 3/28/94

Pump Tank: Gallons; PT Date

Pump Make: Model Serial No.

Nitrification Field: No Fields 1 Square Feet 1350 Linear Feet 450

No Lines 5 Trench Width 3' Max Trench Bottom Depth 36" Gravel Depth 12"

☒ New System ☐ Repair System Type: I, II, III, IV, V, VI

System Description: CONV.

Repair System Description:

Maintenance Agreement Required: ☐ Yes ☐ No

☐ Slab ☐ Crawl Space ☐ Basement w/plumbing ☐ Basement wo/plumbing

☒ House/Mod. Home No. Bedrooms 3

☐ Mobile Home No. Bathrooms 2


☐ Business No. Employees

☐ Other

Water Supply:
☒ Individual
☐ Community
☐ Public

Comments:

INITIAL SITE SKETCH

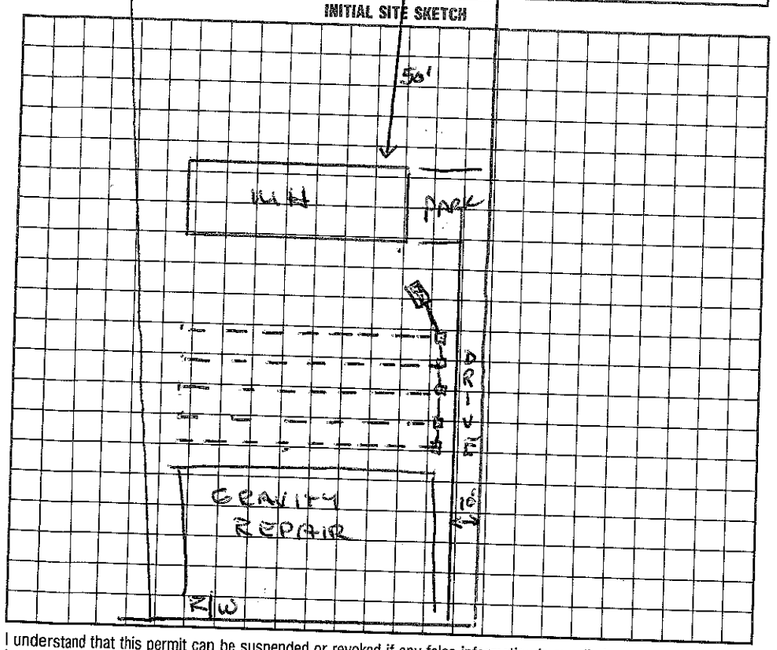


Comments:

AS BUILT SKETCH

I understand that this permit can be suspended or revoked if any false information is supplied toward securing the permit/any unauthorized changes are made to the site/any unauthorized changes are made in the installation of the system. Improvement Permit is valid for 60 months from date of issuance.

Signed: THOROUGHBRED LN.

Improvement Permit by: date

Existing System Inspection by: date

Installed by: James Haddock

Certificate of Completion by: Wesley Sparks R.S. date 6/24/94

Operation Permit by: date

HEALTH DEPT. COPY: WHITE INSPECTION COPY (FINAL): GREEN OWNER COPY (FINAL): YELLOW INSPECTION COPY (INITIAL): PINK OWNER COPY (INITIAL): GOLD