IREDELL COUNTY HEALTH DEPARTMENT

IMPROVEMENT PERMIT / CERTIFICATE OF COMPLETION / OPERATION PERMIT / EXISTING SYSTEM INSPECTION

STATESVILLE 704-878-5305 MOORESVILLE 704-664-5281

PROPERTY DESCRIPTION NO. 18373 DATE 8/8/94 TAX MAP NO. 4E 3A 75

OWNER OR CONTRACTOR Douglas E. Erwin PHONE: Business 4649-86-1822 Home 664-7385

ADDRESS Rt 8 Box 448-A Mooresville NC. Watershed: ☐ Yes ☑ No

LOCATION Palomino Park, ⓛ off Rankin Hill RD., straight to next to last lot on ⓛ

SUBDIVISION Palomino Park BLOCK / SECTION LOT 75 LOT AREA 43,105ft² SITE CLASS. P DESIGN FLOW 360 L.T.A.R. .125-.3

Septic Tank: 1000 Gallons; STB 794 Date 7/6/94
Pump Tank: Gallons; PT Date
Pump Make: Model Serial No.
Nitrification Field: No Fields 1 Square Feet 1200 Linear Feet 400
No Lines 4 Trench Width 36" Max Trench Bottom Depth 32" Gravel Depth 12"

☑ New System ☐ Repair System Type: I, II, III, IV, V, VI
System Description: CONV-DROP Box
Repair System Description:
Maintenance Agreement Required: ☐ Yes ☐ No

☐ House/Mod. Home ☑ Mobile Home ☐ Business ☐ Other
No. Bedrooms 3 No. Bathrooms 2 No. Employees

☐ Slab ☑ Crawl Space ☐ Basement w/plumbing ☐ Basement wo/plumbing


Water Supply: ☑ Individual ☐ Community ☐ Public PROPOSED

Comments:

Comments:

Installed essentially as shown on print.

INITIAL SITE SKETCH

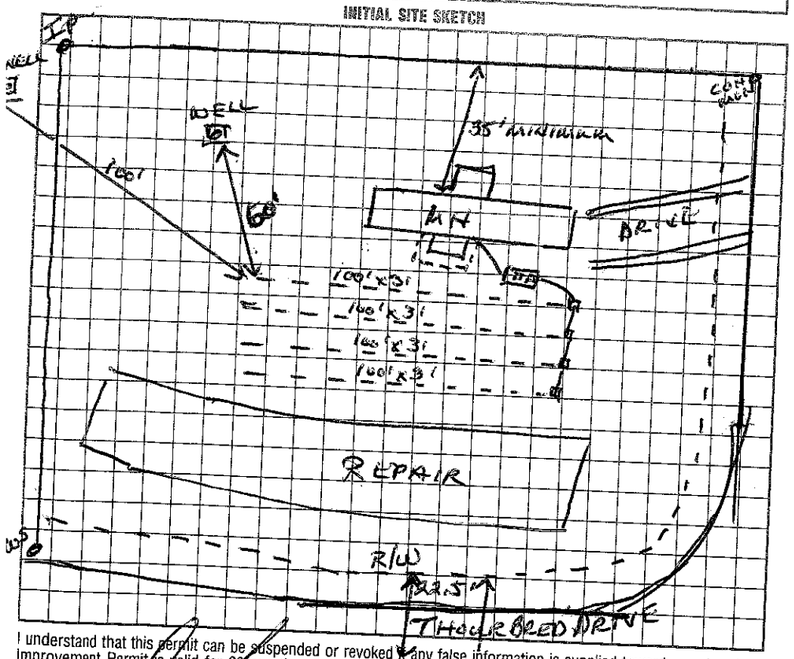

AS BUILT SKETCH

I understand that this permit can be suspended or revoked if any false information is supplied toward securing the permit/any unauthorized changes are made to the site/any unauthorized changes are made in the installation of the system. Improvement Permit is valid for 60 months from date of issuance.

Signed: X Douglas E. Erwin

Improvement Permit by: Wesley Sparks RS, date 8/8/94

Existing System Inspection by: date

Installed by: F S Erwin

Certificate of Completion by: Wesley Sparks RS. date 8/19/94

Operation Permit by: date

HEALTH DEPT. COPY: WHITE INSPECTION COPY (FINAL): GREEN OWNER COPY (FINAL): YELLOW INSPECTION COPY (INITIAL): PINK OWNER COPY (INITIAL): GOLD