IREDELL COUNTY HEALTH DEPARTMENT - *ENVIRONMENTAL HEALTH* ☐ STATESVILLE OFFICE 704-878-5305 ☑ ~~MOO~~RESVILLE OFFICE 704-664-5281

IMPROVEMENT PERMIT / AUTHORIZATION TO CONSTRUCT / OPERATION PERMIT / EXISTING SYSTEM INSPECTION

PERMIT # 171033 PIN # 4649-86-3408 DATE 3-6-12

OWNER GARY LOMAX APPLICANT: FREEDOM HOMES PHONE: Home/Cell # 704-528-7960 Business #

SITE ADDRESS 155 THOROBRED DR. TROUTMAN OWNER / APPLICANT ADDRESS SAME

SITE DIRECTIONS 21 N. RANKIN MILL, THOROBRED

SUBDIVISION PALOMINO PARK BLOCK / SECTION LOT # 11 LOT AREA .68 AC DESIGN FLOW 360 L.T.A.R.

Septic Tank Ex. 1000 Gallons: STB Date

Pump Tank Gallons: P T Date

Pump Make Model Serial #

No. Nitrification Fields: 1 No. Lines 3 Linear Feet 300'

Trench Width Max Trench Bottom Depth EXISTING

☐ New System ☐ Repair ☐ Expansion System Type I (II) III IV V VI

System Description: GRAVEL

Repair System Description:

Maintenance Agreement Required ☐ YES ☑ NO

Gravel Depth ☑ GRAVITY ☐ PRESSURE

☑ Residence No. Bedrooms 3

☐ Business No. Persons

☐ Other No. Employees

☐ Slab ☑ Crawl Space

☐ Basement w/plumbing ☐ Basement w/o plumbing

Water Supply

☑ Private


☐ Public

☐ Community

Comments / Conditions

INITIAL SITE SKETCH

AS BUILT SKETCH

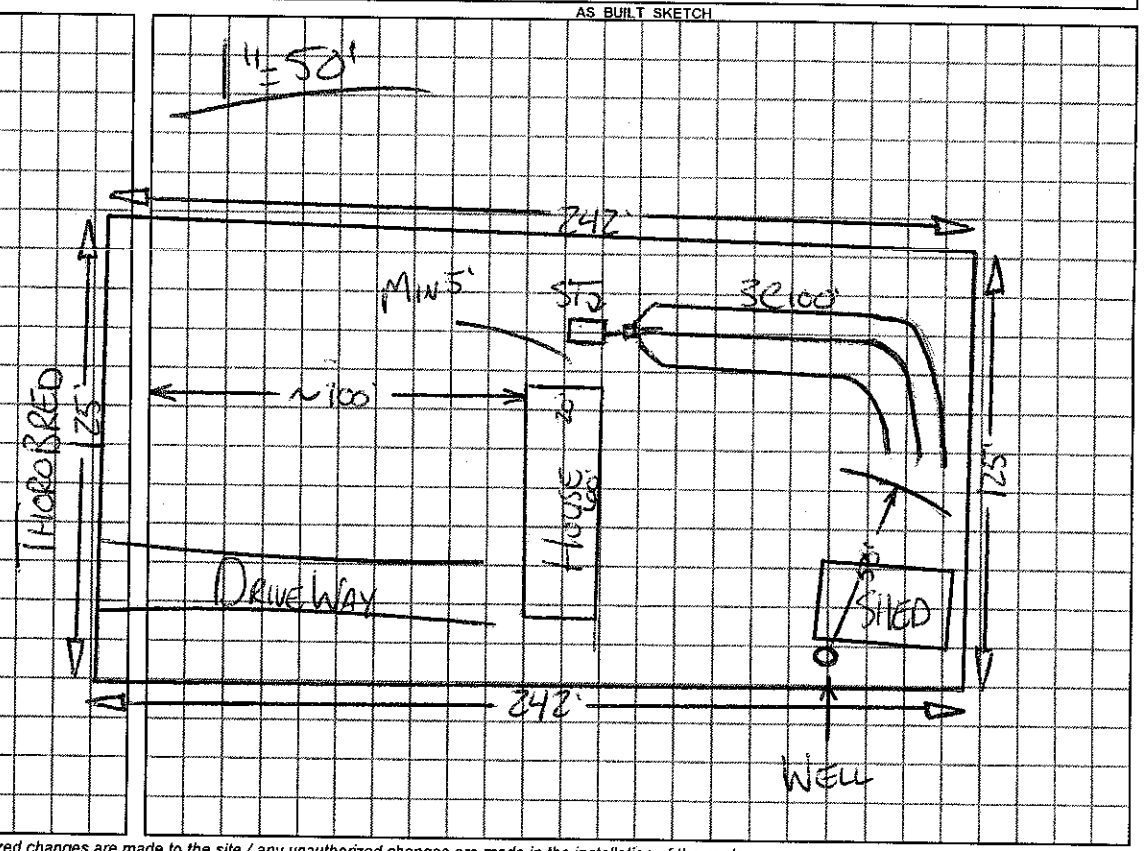

Permit can be suspended or revoked if any false information is supplied toward securing the permit / any unauthorized changes are made to the site / any unauthorized changes are made in the installation of the system.

☐ ***IMPROVEMENT PERMIT*** *with plat valid without expiration.* ☐ ***IMPROVEMENT PERMIT*** *with plat valid without expiration. site plan valid 60 mo.* ☐ ***AUTHORIZATION TO CONSTRUCT*** valid for period equal to IMPROVEMENT PERMIT--not to exceed 60 mo.

Owner / Applicant Signature: Gary Lomax Date 3-7-12

IMPROVEMENT PERMIT by: REHS Date

AUTHORIZATION TO CONSTRUCT by: REHS Date

YOU SHOULD CONTACT A LOCATOR SERVICE PRIOR TO ANY EXCAVATION

Installed by:

OPERATION PERMIT by: REHS Date

Existing System Inspected by: REHS Date 3-6-12

White Copy – Environmental Health YELLOW COPY (Final) Owner / Applicant PINK COPY (Initial) Owner / Applicant