IREDELL COUNTY HEALTH DEPARTMENT

STATESVILLE 704-878-5305 MOORESVILLE 704-664-5281

IMPROVEMENT PERMIT / AUTHORIZATION TO CONSTRUCT / OPERATION PERMIT / EXISTING SYSTEM INSPECTION

$155 fee for type III 10:30

PERMIT# 074455 PIN# 4649 86 41389 DATE 7/15/98

OWNER OR CONTRACTOR Pruitt Development PHONE: Business Home 660-5900

ADDRESS 142 Stutts Rd. Mooresville, NC. 28115

LOCATION 298 Sailwinds Rd; 1.15 N TL Sailwinds Rd. on (R) 2 lots before cul-de-sac

SUBDIVISION Windward Pointe BLOCK / SECTION 2 LOT 104 LOT AREA .59 AC SITE CLASS. PS DESIGN FLOW 360 L.T.A.R. .3

Septic Tank: 1000 Gallons; STB 1012 Date 5/11/99

Pump Tank: Gallons; PT Date

Pump Make: Model 900 Serial No.

Nitrification Field: No Fields 1 Square Feet ~~1200~~ Linear Feet ~~400~~ 300

No Lines 5 Trench Width 36" Max Trench Bottom Depth 36" Gravel Depth 12"

[X] New System [ ] Repair System Type: I [X] II III IV V VI

System Description: Gravity - Conventional

Repair System Description: None

Maintenance Agreement Required: [ ] Yes [X] No Chambers

[X] House/Mod. Home No. Bedrooms 3

[ ] Mobile Home No. Bathrooms 2

[ ] Business No. Employees

[ ] Other


[ ] Slab [X] Crawl Space [ ] Basement w/plumbing [ ] Basement wo/plumbing

Water Supply: [X] Individual [ ] Public [ ] Community


Comments:/Conditions: 7/15/99 - Changed to 5 - 60'x3' lines of Chambered Plastic material - AWS.

Comments:/Conditions:

INITIAL SITE SKETCH

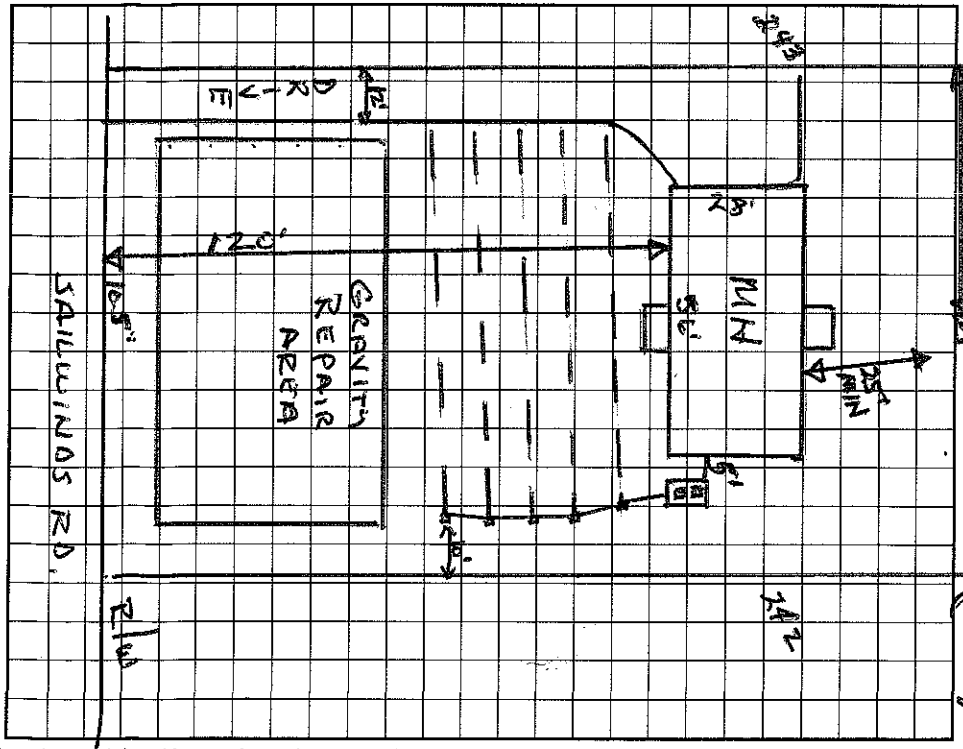

AS BUILT SKETCH

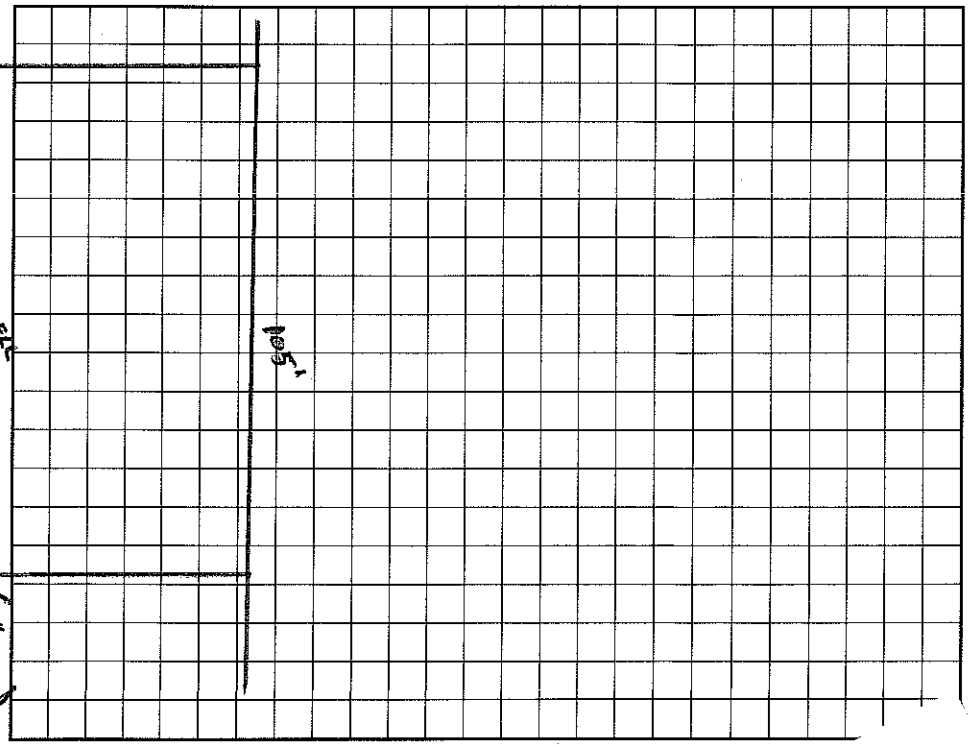

I understand that this permit can be suspended or revoked if any false information is supplied toward securing the permit/any unauthorized changes are made to the site/any unauthorized changes are ma[de] tion of the system. Improvement Permit with plat valid without expiration. Improvement Permit with site plan valid for sixty months. Authorization to Construct is valid for a period equal to that of Im[p] to exceed sixty months.

Signed: X date

Improvement Permit by: Wesley Spencer RS. date 9/15/98

Authorization to Construct by: Wesley Spencer RS date 7/15/98

Installed by: A1 BACKHOE

Operation Permit by: C. [illegible]

Existing System Inspection by:

HEALTH DEPT. COPY: WHITE INSPECTION COPY (FINAL): GREEN OWNER COPY (FINAL): YELLOW INSPECTION COPY (IN[I])