IREDELL COUNTY HEALTH DEPARTMENT

STATESVILLE 704-878-5305 MOORESVILLE 704-664-5281

IMPROVEMENT PERMIT / AUTHORIZATION TO CONSTRUCT / OPERATION PERMIT / EXISTING SYSTEM INSPECTION

PERMIT# 134591 PIN# 4649864725 DATE 4-13-06

OWNER OR APPLICANT Nancy Newcomb PHONE: Business 704-883-9473 Home 704-450-0830

ADDRESS 295 Sailwinds Rd Mooresville 28115

LOCATION Hwy 21 N TL Flowerhouse TR Rankin Hill Rd TL Thoroughbred Dr. on Rt 123 Thoroughbred Dr.

SUBDIVISION Palomino Park BLOCK / SECTION ____ LOT 13 LOT AREA ____ SITE CLASS. ____ DESIGN FLOW ____ L.T.A.R. ____

Septic Tank: Existing Gallons: STB ____ Date ____
Pump Tank: ____ Gallons: PT ____ Date ____
Pump Make: ____ Model ____ Serial No. ____
Nitrification Field: No Fields ____ Square Feet ____ Linear Feet ____
No Lines ____ Trench Width ____ Max Trench Bottom Depth ____ Gravel Depth ____

☐ New System ☐ Repair ☐ Expansion System Type: I ☒ II III IV V VI
System Description: Existing Conventional
Repair System Description: ____
Maintenance Agreement Required: ☐ Yes ☒ No


☐ House/Mod. Home ☒ Mobile Home ☐ Business ☐ Other ____
No. Bedrooms 3 No. Persons ____ No. Employees ____

Water Supply: ☒ Individual ☐ Public ☐ Community

☐ Gravity ☐ Pressure ☐ Slab ☒ Crawl Space ☐ Basement w/plumbing ☐ Basement wo/plumbing


Comments:/Conditions:

Existing System ~~INITIAL SITE SKETCH~~

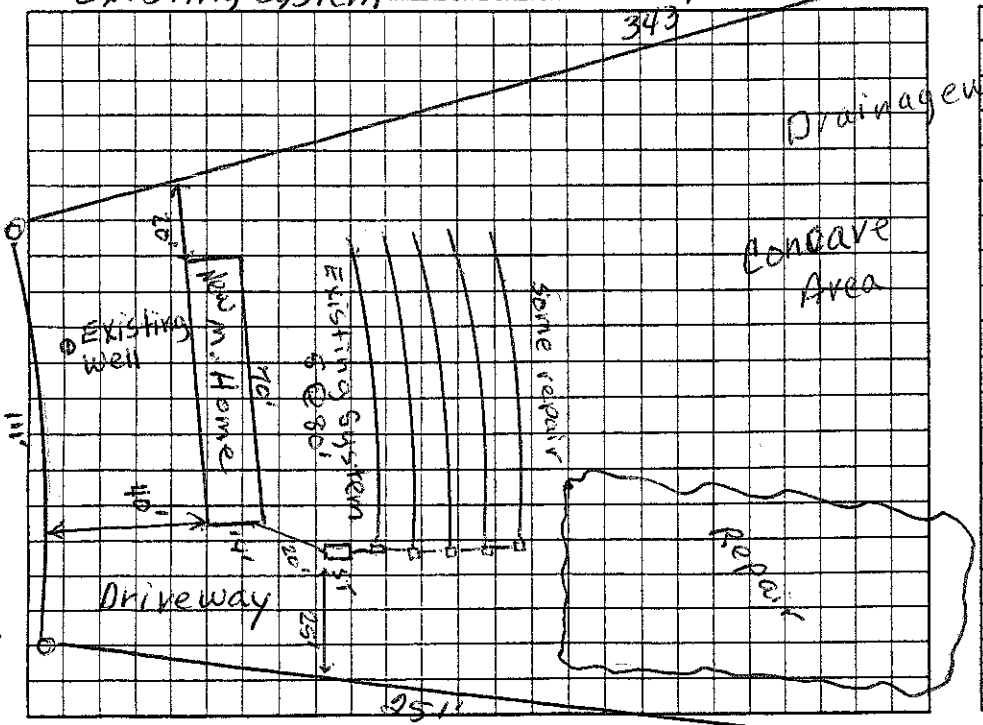

Comments:/Conditions:

AS BUILT SKETCH

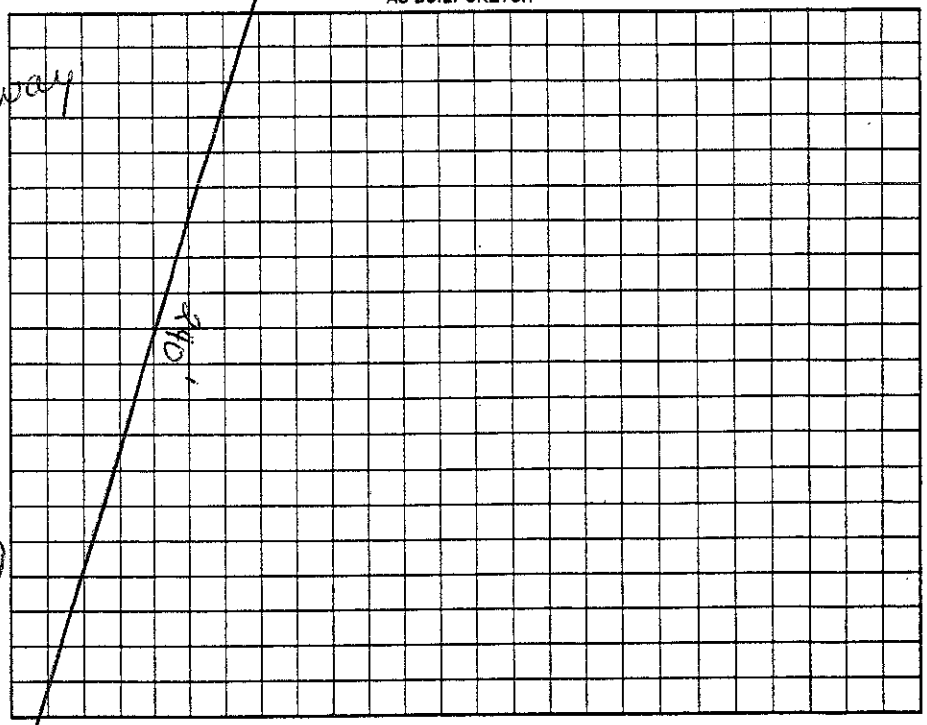

Permit can be suspended or revoked if any false information is supplied toward securing the permit/any unauthorized changes are made to the site/any unauthorized changes are made in the installation of the system. Improvement Permit with plat valid without expiration ☐ Improvement Permit with site plan valid for sixty months ☒ Authorization to Construct is valid for a period equal to that of Improvement Permit – not to exceed sixty months.

Signed: Nancy Newcomb date 4/13/06 Installed by: ____

Improvement Permit by: ____ date ____ Operation Permit by: ____ date ____

Authorization to Construct by: ____ date ____ Existing System Inspection by: Judy McNeill date 4-13-06

HEALTH DEPT. COPY: WHITE OWNER COPY (FINAL): YELLOW OWNER COPY (INITIAL): PINK

Thoroughbred Dr.