IREDELL COUNTY HEALTH DEPARTMENT

Authorization to Construct

STATESVILLE 704-878-5305 MOORESVILLE 704-664-5281

IMPROVEMENT PERMIT / ~~CERTIFICATE OF COMPLETION~~ / OPERATION PERMIT / EXISTING SYSTEM INSPECTION

PROPERTY DESCRIPTION NO. 069111 DATE 9/4/97 TAX MAP NO. 4649 86 4961 Watershed: ☐ Yes ☒

OWNER OR CONTRACTOR Virgil R Alfrey PHONE: Business _____ Home 662-9257

ADDRESS 105 Hagen Point Ln. Mooresville, NC. 28115

LOCATION 128 Thoroughbred Dr. on (R)

SUBDIVISION Performance Park BLOCK / SECTION _____ LOT 14 LOT AREA ~1 AC SITE CLASS. PS DESIGN FLOW 360 L.T.A.R. N/R

Septic Tank: 1000 Gallons; STB 794 Date 8/27/97

Pump Tank: _____ Gallons; PT _____ Date _____

Pump Make: _____ Model _____ Serial No: _____

Nitrification Field: No Fields — Square Feet — Linear Feet —

No Lines _____ Trench Width _____ Max Trench Bottom Depth _____ Gravel Depth _____

☐ New System ☒ Repair System Type: I (II) III, IV, V, VI

System Description: RELOCATE S/T

Repair System Description: _____

Maintenance Agreement Required: ☐ Yes ☐ No

☐ House/Mod. Home No. Bedrooms 3

☒ Mobile Home No. Bathrooms 2

☐ Business No. Employees _____

☐ Other _____


☐ Slab ☐ Crawl Space ☐ Basement w/plumbing ☐ Basement wo/plumbing

Water Supply:
~~☐ Individual~~
☐ Community
☐ Public

Comments:
RELOCATE S/T IN A MANNER THAT DISTRIBUTION BOX CAN BE PROPERLY RE-PLUMBED

Comments:

INITIAL SITE SKETCH

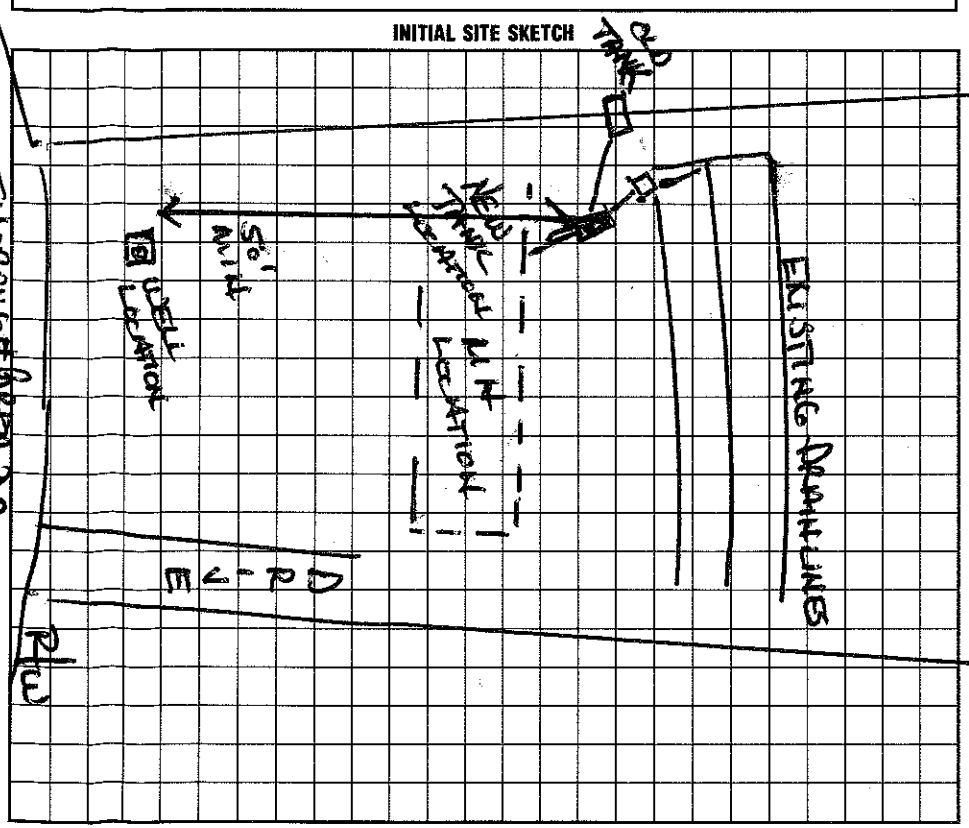

AS BUILT SKETCH

I understand that this permit can be suspended or revoked if any false information is supplied toward securing the permit/any unauthorized changes are made to the site/any unauthorized changes are made in the installation of the system. Improvement Permit is valid for 60 months from date of issuance.

Signed: Virgil Alfrey

Improvement Permit by: Wesley Sparks R.S. date 9/4/97

~~Existing System Inspection by~~: Wesley Sparks R.S. date 9/4/97

Installed by: Foothills Const.

Certificate of Completion by: Wesley Sparks R.S. date 9/17/97

Operation Permit by: Wesley Sparks R.S. date 9/17/97

HEALTH DEPT. COPY: WHITE INSPECTION COPY (FINAL): GREEN OWNER COPY (FINAL): YELLOW INSPECTION COPY (INITIAL): PINK OWNER COPY (INITIAL): GOLD