IREDELL COUNTY HEALTH DEPARTMENT

STATESVILLE 704-878-5305 MOORESVILLE 704-664-5281

IMPROVEMENT PERMIT / AUTHORIZATION TO CONSTRUCT / OPERATION PERMIT / EXISTING SYSTEM INSPECTION

PERMIT# 074453 PIN# 4649 86 5486 DATE 7/21/98

OWNER OR CONTRACTOR Pruitt Dev. Co. PHONE: Business 660-5900 Home

ADDRESS 142 Stutts Rd. Mooresville, NC 28115

LOCATION 115 N TL Sailwinds Rd. on (R) 5 lot before cul de sac

SUBDIVISION Windward Pointe BLOCK / SECTION TT LOT 101 LOT AREA .60 SITE CLASS. RS DESIGN FLOW 360 L.T.A.R. .3

Septic Tank: 1000 Gallons; STB 1012 Date 6-24-98
Pump Tank: Gallons; PT Date
Pump Make: Model Serial No.
Nitrification Field: No Fields 1 Square Feet 900 Linear Feet 300
No Lines 4 Trench Width 36" Max Trench Bottom Depth 36" Gravel Depth 3 AND.

[X] New System [ ] Repair System Type: I, II, III, IV, V, VI
System Description: Brentwood Plastic
Repair System Description: Same
Maintenance Agreement Required: [ ] Yes [X] No


[X] House/Mod. Home No. Bedrooms 3
[ ] Mobile Home No. Bathrooms 3
[ ] Business No. Employees
[ ] Other
[ ] Slab [X] Crawl Space [ ] Basement w/plumbing [ ] Basement wo/plumbing

Water Supply: [X] Individual [ ] Public [ ] Community

Comments:/Conditions:

Comments:/Conditions:

INITIAL SITE SKETCH

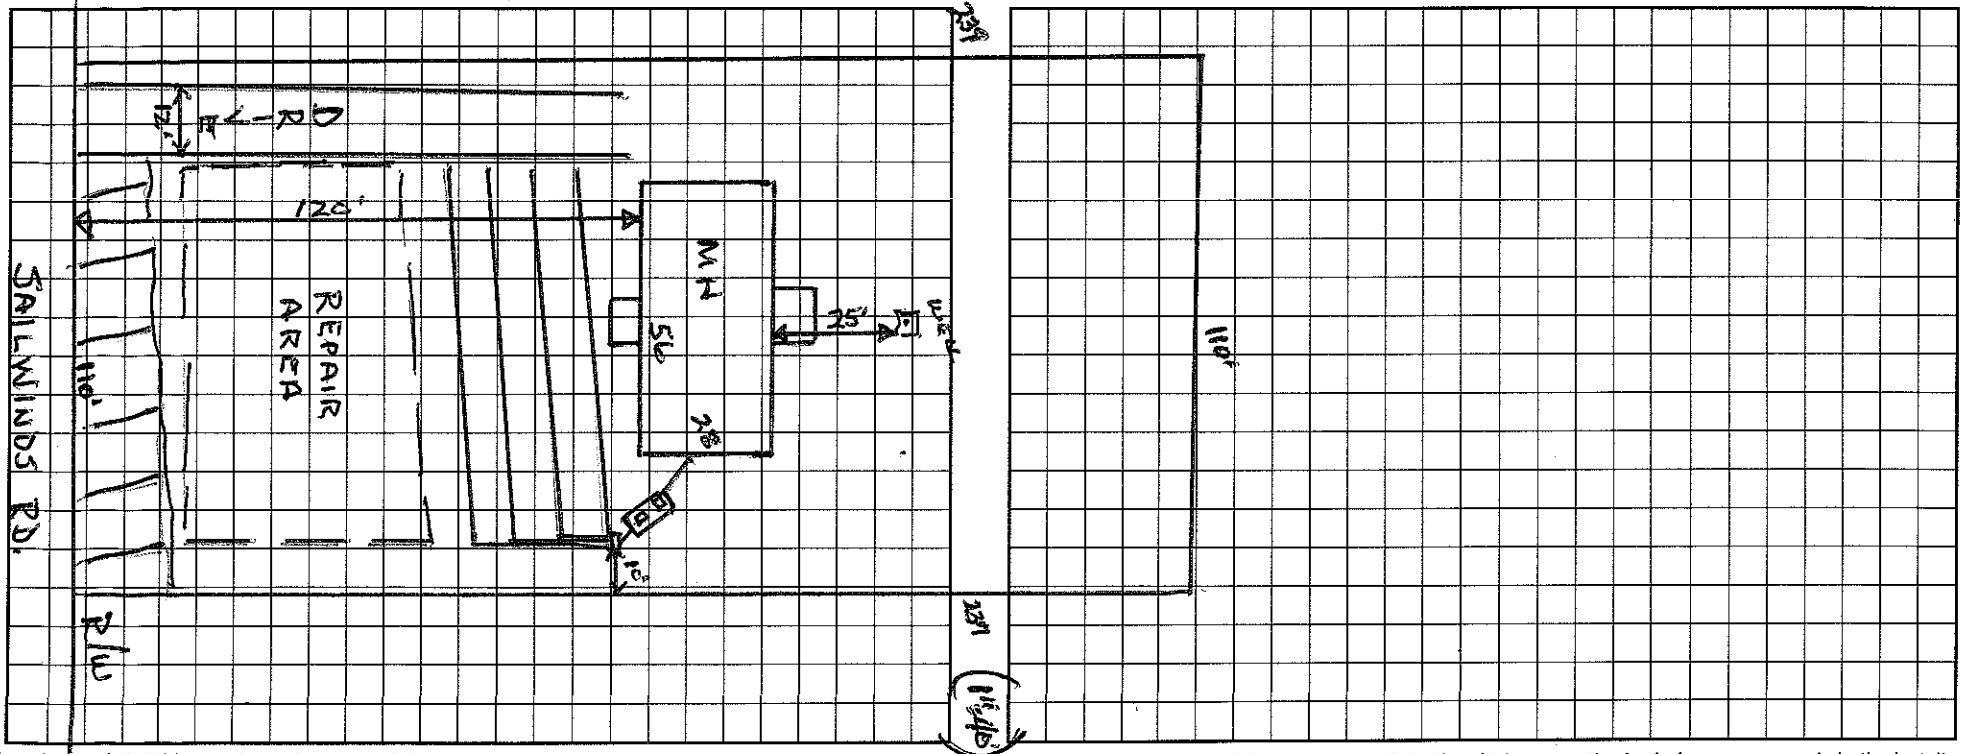

AS BUILT SKETCH

I understand that this permit can be suspended or revoked if any false information is supplied toward securing the permit/any unauthorized changes are made to the site/any unauthorized changes are made in the installation of the system. Improvement Permit with plat valid without expiration. Improvement Permit with site plan valid for sixty months. Authorization to Construct is valid for a period equal to that of Improvement Permit – not to exceed sixty months.

Signed: X date

Improvement Permit by: Wesley Sparks RS. date 7/21/98

Authorization to Construct by: Wesley Sparks RS. date 7/21/98

Installed by: A1 BACKHOE

Operation Permit by: C. [signature] date 8/24/98

Existing System Inspection by: date

HEALTH DEPT. COPY: WHITE INSPECTION COPY (FINAL): GREEN OWNER COPY (FINAL): YELLOW INSPECTION COPY (INITIAL): PINK OWNER COPY (INITIAL): GOLD