2:30

IREDELL COUNTY HEALTH DEPARTMENT

STATESVILLE 704-878-5305 MOORESVILLE 704-664-5281

IMPROVEMENT PERMIT / AUTHORIZATION TO CONSTRUCT / OPERATION PERMIT / EXISTING SYSTEM INSPECTION

PERMIT# 076474 PIN# 4649 86 9328 DATE 10/26/98

OWNER OR CONTRACTOR PLOTT DEV PHONE: Business Home

ADDRESS 412 STOTTS RD - MOORESVILLE 28117

LOCATION 21/115 N - TL SALISBURY - ON LT

SUBDIVISION WINWARD FT BLOCK / SECTION 2 LOT 114 LOT AREA 1.11AC SITE CLASS. RS DESIGN FLOW 360 L.T.A.R. .3

Septic Tank: 1050 Gallons; STB 1012 Date 10/26/99
Pump Tank: Gallons; PT Date
Pump Make: Model Serial No.
Nitrification Field: No Fields 1 Square Feet 100 Linear Feet 300
No Lines 4@75' Trench Width 36" Max Trench Bottom Depth 31" Gravel Depth N/A

☒ New System ☐ Repair System Type: I, II, III, IV, V, VI
System Description: GRAVITY CHAMBERS OR NDS
Repair System Description: STONE
Maintenance Agreement Required: ☐ Yes ☒ No


☒ House/Mod. Home No. Bedrooms 3
☐ Mobile Home No. Bathrooms 2
☐ Business No. Employees
☐ Other
☐ Slab ☐ Crawl Space ☐ Basement w/plumbing ☐ Basement wo/plumbing

Water Supply: ☒ Individual ☐ Public ☐ Community


Comments:/Conditions:

Comments:/Conditions: EZ LAY INSTALLED
DROP BOXES
NO WELL

INITIAL SITE SKETCH 1" = 60'

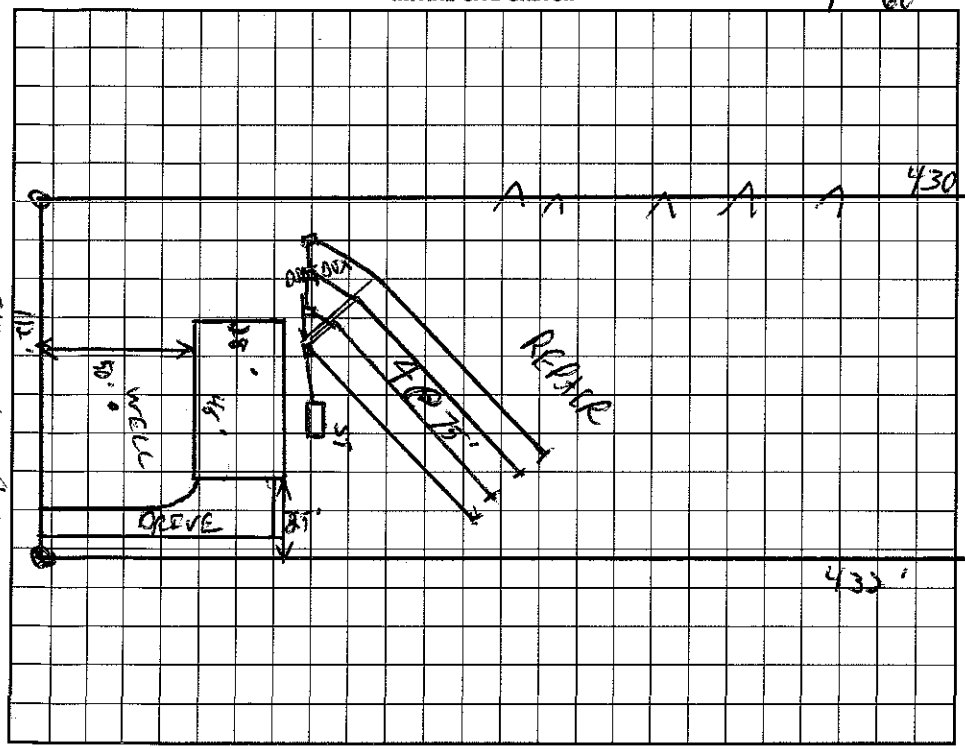

AS BUILT SKETCH

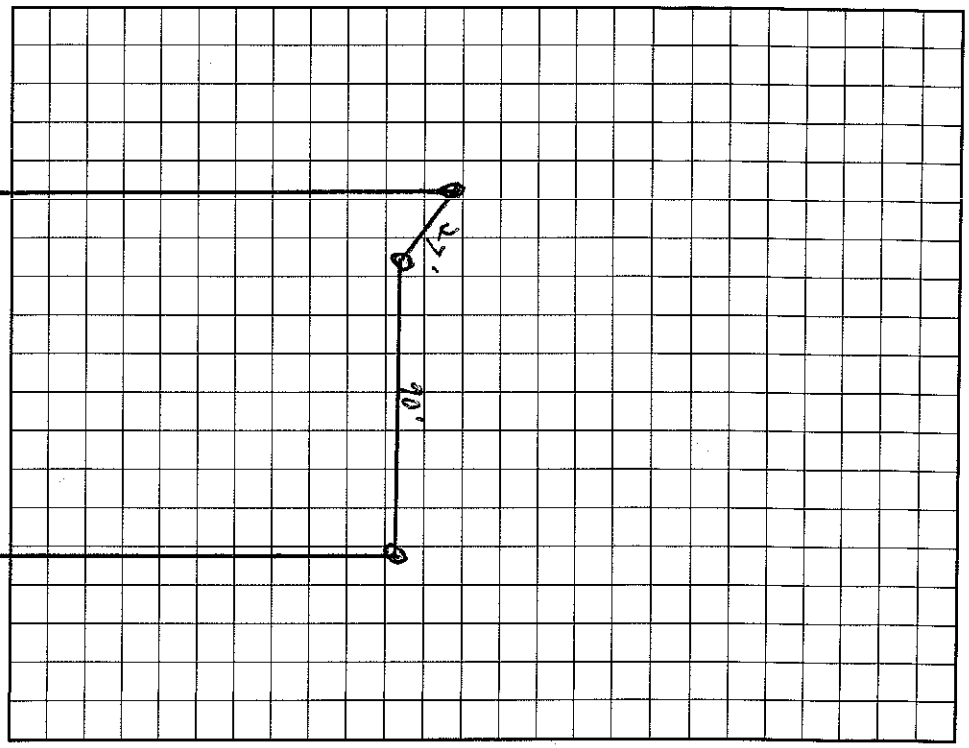

I understand that this permit can be suspended or revoked if any false information is supplied toward securing the permit/any unauthorized changes are made to the site/any unauthorized changes are made in the installation of the system. Improvement Permit with plat valid without expiration. Improvement Permit with site plan valid for sixty months. Authorization to Construct is valid for a period equal to that of Improvement Permit – not to exceed sixty months.

Signed: date 11/5/98 Installed by: A-1 Backhoe

Improvement Permit by: C. Bryan ES date 10/26/98 Operation Permit by: Wesley Sparks E.S. date 2/17/00

Authorization to Construct by: C. Bryan ES date 10/26/98 Existing System Inspection by: date

HEALTH DEPT. COPY: WHITE INSPECTION COPY (FINAL): GREEN OWNER COPY (FINAL): YELLOW INSPECTION COPY (INITIAL): PINK OWNER COPY (INITIAL): GOLD