IREDELL COUNTY HEALTH DEPARTMENT

STATESVILLE 704-878-5305 MOORESVILLE 704-664-5281

IMPROVEMENT PERMIT / AUTHORIZATION TO CONSTRUCT / OPERATION PERMIT / EXISTING SYSTEM INSPECTION

PERMIT# 136526 PIN# 4649872149

OWNER OR APPLICANT Clayton Homes PHONE: Business 873-2541 Home

ADDRESS 2026 Northside Dr Statesville, NC 28677 DATE 6-30-06

LOCATION Hwy 115/21 TL Flowerhouse TR Rankin Hill TL, Sorrell Property on Rt

SUBDIVISION Palomino Pk BLOCK / SECTION LOT 17 LOT AREA .702 Acre SITE CLASS PS DESIGN FLOW 360 L.T.A.R.

EXIST

Septic Tank: 1000 Gallons; STB Date

Pump Tank: Gallons; PT Date

Pump Make: Model Serial No.

Nitrification Field: No Fields Square Feet Exist Linear Feet 360

No Lines 3 Trench Width 36" Max Trench Bottom Depth Gravel Depth 12"

☐ New System ☐ Repair ☐ Expansion System Type: I II III IV V VI

System Description: Existing Gravity-Conventional

Repair System Description: Pump-Panel Blk

Maintenance Agreement Required: ☐ Yes ☐ No

☐ House/Mod. Home No. Bedrooms 3

☐ Mobile Home No. Persons

☐ Business No. Employees

☐ Other

Water Supply: ☐ Individual ☐ Public ☐ Community


☒ Gravity ☐ Pressure ☐ Slab ☐ Crawl Space ☐ Basement w/plumbing ☐ Basement wo/plumbing

Comments:/Conditions: Existing Septic System appears to be functioning okay at the time of inspection.

Comments:/Conditions: Keep New house 5-10FT From Existing Septic System.

INITIAL SITE SKETCH

AS BUILT SKETCH

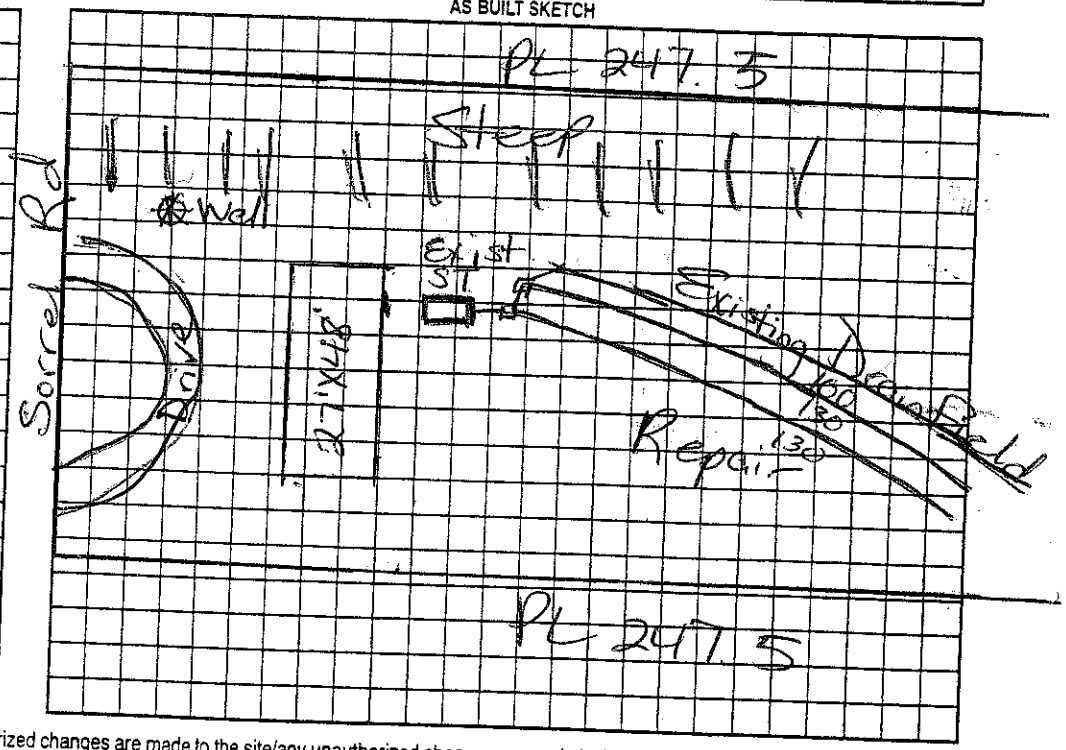

Permit can be suspended or revoked if any false information is supplied toward securing the permit/any unauthorized changes are made to the site/any unauthorized changes are made in the installation of the system. Improvement Permit with plat valid without expiration ☐ Improvement Permit with site plan valid for sixty months ☐ Authorization to Construct is valid for a period equal to that of Improvement Permit – not to exceed sixty months.

Signed: date 6/30/06

Improvement Permit by: date

Authorization to Construct by: Maria H Dolan RS date 6/30/06

Installed by:

Operation Permit by: date

Existing System Inspection by: Maria H Dolan RS date 6/30/06

HEALTH DEPT. COPY: WHITE OWNER COPY (FINAL): YELLOW OWNER COPY (INITIAL): PINK